


CORNER RECORD

Document Number 00-46
County of San Joaquin, California

City of _____

Brief Legal Description Intersection of Jack Tone Road and Locketford Ranch
Road per PM-19-165

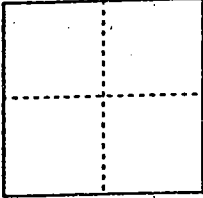

CORNER TYPE

- Government Corner Control
- Meander Property
- Rancho Other

Date of Survey 12-27-99

COORDINATES (Optional)

N. _____
 E. _____
 Zone _____ NAD27 NAD83
 NAD83 Epoch _____
 Elev. _____
 Vert. Datum: NGVD29 NAVD88
 Meas. Units: Metric Imperial

Corner - Left as found Found and tagged Established Reestablished Rebuilt

Identification and type of corner found: Evidence used to identify or procedure used to establish or reestablish the corner:
Reestablished location of Fd. Railroad Spike (Not Tagged) per PM-19-165
per Swingties on C.R. - 00-45
See Sketch on Backside

A description of the physical condition of the monument as found and as set or reset: Fd. Railroad Spike (Not Tagged) per PM-19-165 in good condition and placed Mon. Box over Monument.
See Sketch on Backside

SURVEYOR'S STATEMENT

This Corner Record was prepared by me or under my direction in conformance with the Land Surveyors' Act on 2 Feb, 2000.

Signed _____ L.S. or R.C.E. Number 23341



COUNTY SURVEYOR'S STATEMENT

This Corner Record was received 2-4-, 2000 and examined and filed 2-7-, 2000.

Signed Henry M. Hirata R.C.E. No. 21258

Title County Surveyor



County Surveyors Comment _____

Fd nail & washer stamped "S.J. Co."

JP

1816' 63"

Fire Hydrant Fd 69381


Lockeford Ranch Rd

4820'

JP

Fd. P.K. nail & washer stamped "S.J. Co."

Jack Tone Rd

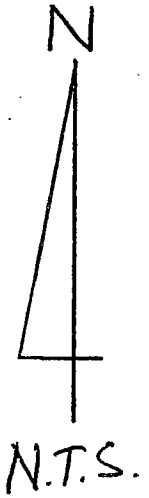

(Not Tagged)
Found R.R. spike
(per PM-19-165)
(Placed Mon Box over Mon.)

"No Attempt Was Made To Verify Monument(s)"

Note: "Fd." tie on Fire Hydrant is punched dot on N/E bolt

- FP = Fence Post
- GP = Guy Post
- JP = Joint Pole
- PP = Power Pole
- SP = Service Pole
- TP = Telephone Pole
- N.T.S. = Not To Scale
- Fd. = Conc. Nails with Brass Washers Stamped "S.J. Co.", unless otherwise noted