


CORNER RECORD

Document Number 00-53
County of San Joaquin, California

City of _____

Brief Legal Description INTERSECTION OF MARIPOSA ROAD AND
DROGE. ROAD per RS-34-11

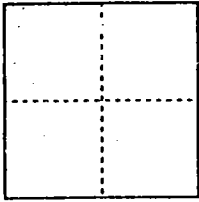

CORNER TYPE

- Government Corner Control
- Meander Property
- Rancho Other

Date of Survey 12-7-99

COORDINATES (Optional)

N. _____
 E. _____
 Zone _____ NAD27 NAD83
 NAD83 Epoch _____
 Elev. _____
 Vert. Datum: NGVD29 NAVD88
 Meas. Units: Metric Imperial

Corner - Left as found Found and tagged Established Reestablished Rebuilt


Identification and type of corner found: Evidence used to identify or procedure used to establish or reestablish the corner:
SEE SKETCH ON BACKSIDE

A description of the physical condition of the monument as found and as set or reset: _____
FOUND MONUMENT IN GOOD CONDITION
SEE SKETCH ON BACKSIDE

SURVEYOR'S STATEMENT

This Corner Record was prepared by me or under my direction in conformance with the Land Surveyors' Act on 2 Feb, 2000

Signed _____ L.S. or R.C.E. Number 23341

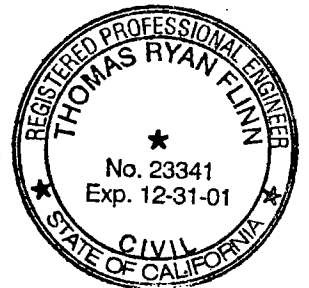

COUNTY SURVEYOR'S STATEMENT

This Corner Record was received 2-4-, 2000 and examined and filed 2-7-, 2000

Signed Henry M. Hirata R.C.E. No. 21258
Title County Surveyor



County Surveyors Comment _____

(D.D. Sheet No. 43)

N.



N.T.S.

DROGE ROAD

JOINT POLE SET

36' 12"

FOUND PK NAIL (Not Tagged)
PER R.S 34-11

47' 10"

TELEPHONE POLE SET

14' 58"

TELEPHONE POLE SET

MARIPOSA ROAD

ALL 'SET' ARE CONCRETE
NAIL & BRASS WASHERS
STAMPED S.J. CO.

"No attempt was made to verify Monument"