


CORNER RECORD

City of 450[±] Document Number 00-68
County of San Joaquin, California

Brief Legal Description Airport Way Southwesterly of French Camp Road
F.B 666, Pg 27

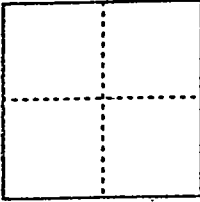

CORNER TYPE

Government Corner Control
Meander Property
Rancho Other
Date of Survey 10-06-99

COORDINATES (Optional)

N. _____
E. _____
Zone _____ NAD27 NAD83
NAD83 Epoch _____
Elev. _____
Vert. Datum: NGVD29 NAVD88
Meas. Units: Metric Imperial

Corner - Left as found Found and tagged Established Reestablished Rebuilt

Identification and type of corner found: Evidence used to identify or procedure used to establish or reestablish the corner:
See Sketch on Backside

A description of the physical condition of the monument as found and as set or reset:
Found Monument in good condition
See Sketch on Backside

SURVEYOR'S STATEMENT

This Corner Record was prepared by me or under my direction in conformance with the Land Surveyors' Act on 2 Feb, 2000.


Signed [Signature] L.S. or R.C.E. Number 23341



COUNTY SURVEYOR'S STATEMENT

This Corner Record was received 2-4-, 2000 and examined and filed 2-7, 2000.

Signed Henry M. Hirata R.C.E. No. 21258
Title County Surveyor

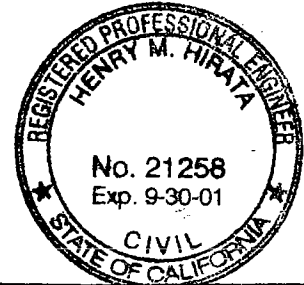

County Surveyors Comment _____

"No Attempt Was Made To Verify Measurement(s)"

- FP = Fence Post
- GP = Guy Post
- JP = Joint Pole
- PP = Power Pole
- SP = Service Pole
- TP = Telephone Pole
- N.T.S. = Not To Scale

Set = Conc. Nails with Brass Washers Stamped "S.J. Co.", unless otherwise noted



N.T.S.

FRENCH CAMP ROAD

AIRPORT WAY

T.P. SET

65' 25"

J.P. SET

70' 09"

69' 74"

FOUND PK NAIL & SHINER (Not Tagged)

(# 353-0992 per FBI logs)
C- 26-21-72

SET
FENCE POST.

