


CORNER RECORD

Document Number 00-79
County of San Joaquin, California

City of _____

Brief Legal Description S/W CORNER OF S/E 1/4 OF SECTION 15,
T.3 N., R.7E.

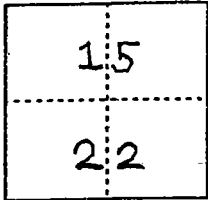

T.3 N., R.7E.

CORNER TYPE

- Government Corner Control
- Meander Property
- Rancho Other

Date of Survey 11-6-99

COORDINATES (Optional)

N. _____
 E. _____
 Zone _____ NAD27 NAD83
 NAD83 Epoch _____
 Elev. _____
 Vert. Datum: NGVD29 NAVD88
 Meas. Units: Metric Imperial

Corner - Left as found Found and tagged Established Reestablished Rebuilt

Identification and type of corner found: Evidence used to identify or procedure used to establish or reestablish the corner:

SEE SKETCH ON BACKSIDE

A description of the physical condition of the monument as found and as set or reset:

MONUMENT WAS IN GOOD CONDITION
SEE SKETCH ON BACKSIDE

SURVEYOR'S STATEMENT

This Corner Record was prepared by me or under my direction in conformance with the Land Surveyors' Act on Feb 4, 2000.

Signed [Signature] or R.C.E. Number 23341


COUNTY SURVEYOR'S STATEMENT


This Corner Record was received 2-4-, 2000 and examined and filed 2-7-, 2000.

Signed Henry M. Hirata R.C.E. No. 21258

Title County Surveyor

County Surveyors Comment _____

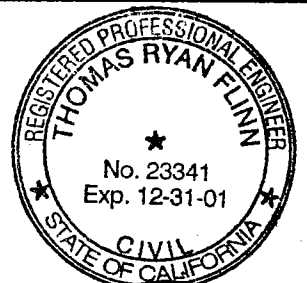

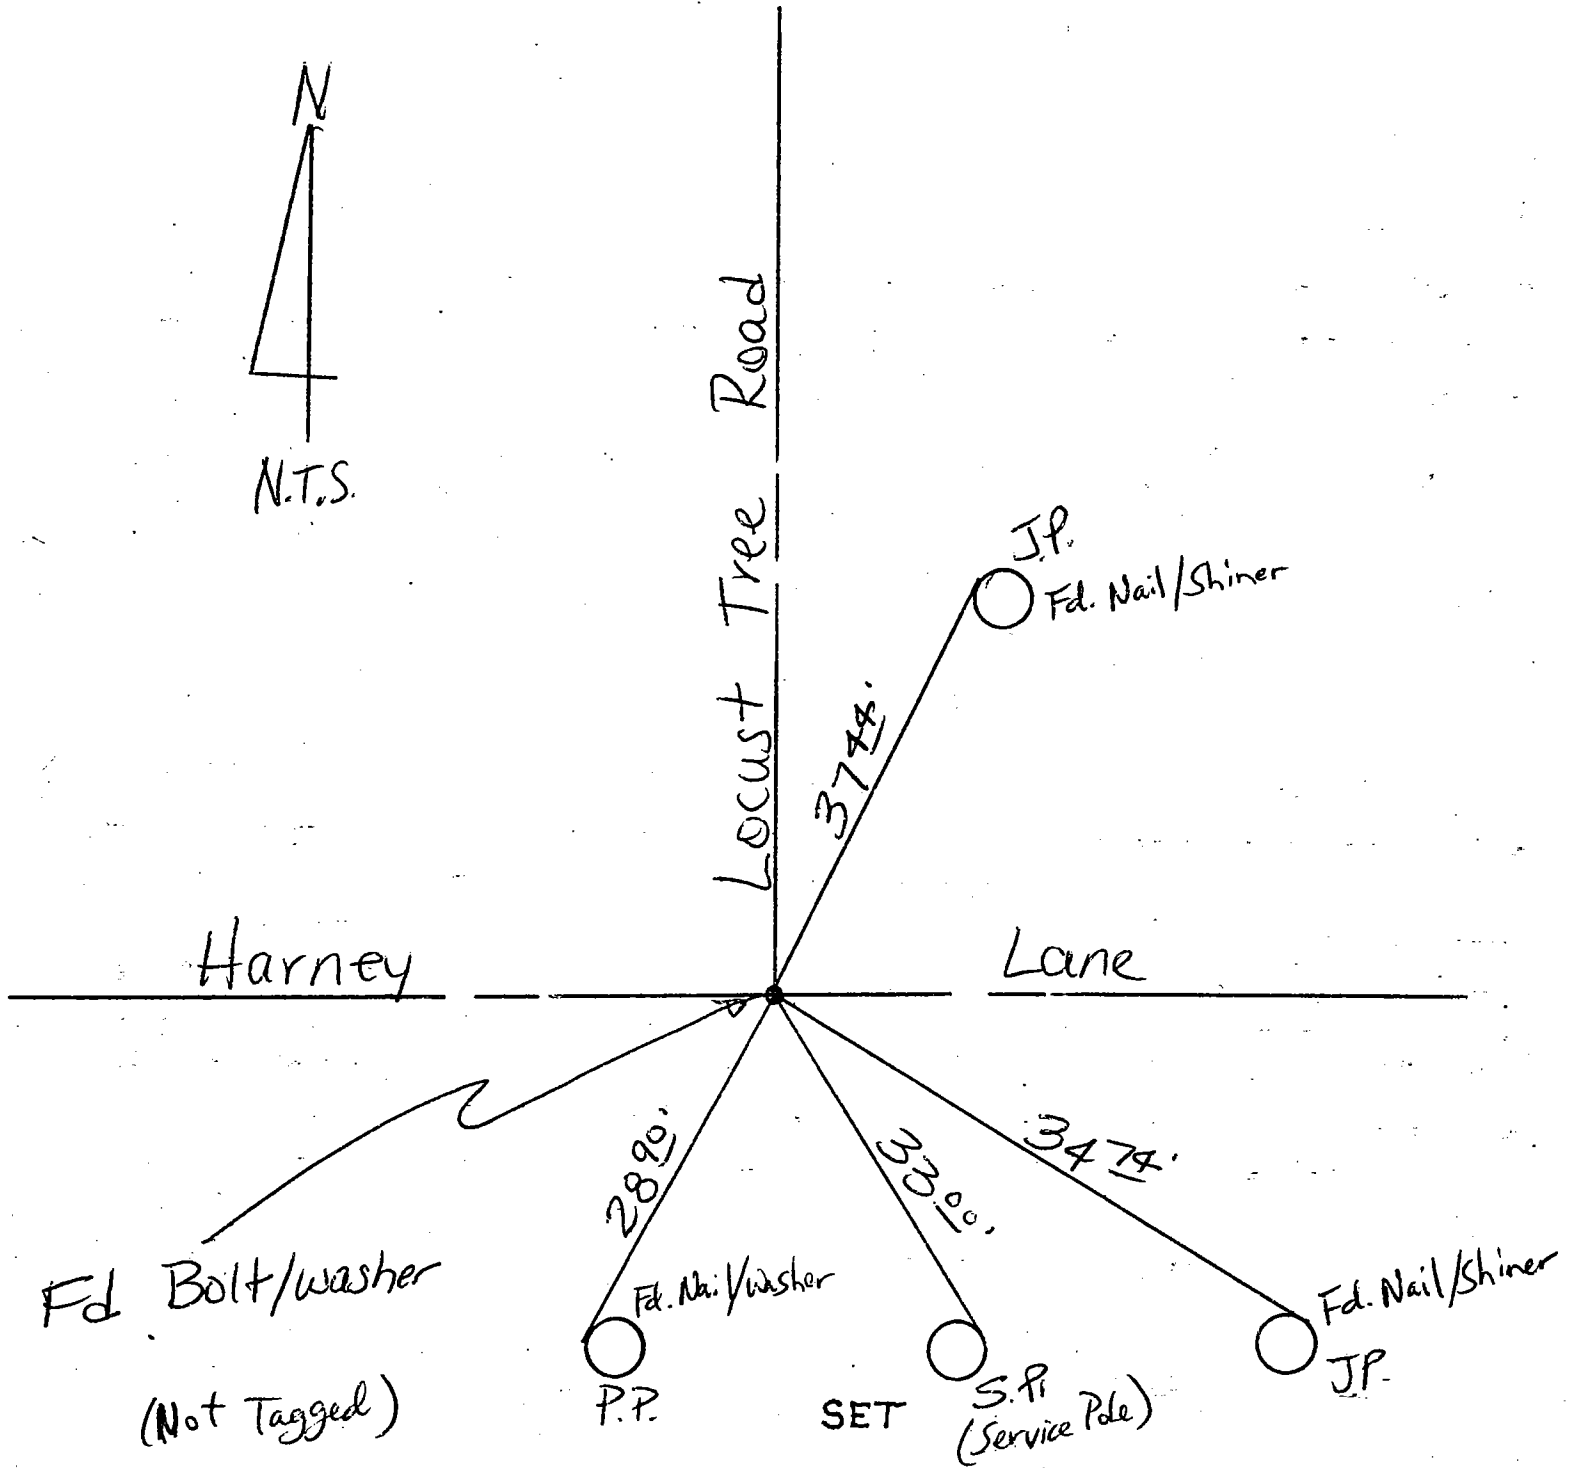

"No Attempt Was Made To Verify Monument(s)"

- FP = Fence Post
- GP = Guy Post
- JP = Joint Pole
- PP = Power Pole
- SP = Service Pole
- TP = Telephone Pole
- N.T.S. = Not To Scale

"Set" means Conc. Nail with
Brass Washer Stamped "S.J. Co."

Set = Conc. Nails with Brass Washers Stamped "S.J. Co.", unless otherwise noted