


CORNER RECORD

Document Number 00-148
County of San Joaquin, California

City of _____

Brief Legal Description 13.24 ACRE PARCEL SHOWN ON R.S. 20-162,
S.J.C.R.

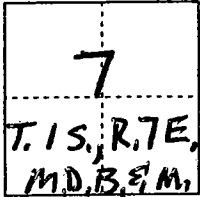

CORNER TYPE

Government Corner Control
Meander Property
Rancho Other
Date of Survey Dec 15, 1999

COORDINATES (Optional)

N. _____
E. _____
Zone _____ NAD27 NAD83
NAD83 Epoch _____
Elev. _____
Vert. Datum: NGVD29 NAVD88
Meas. Units: Metric Imperial

Corner - Left as found Found and tagged Established Reestablished Rebuilt

Identification and type of corner found: Evidence used to identify or procedure used to establish or reestablish the corner:

—●— Found as noted on sketch on reverse side

A description of the physical condition of the monument as found and as set or reset: I SET A 3/4" X 30"
IRON PIPE TAGGED L.S. 4450 AT THE SOUTHEAST AND SOUTHWEST
CORNER OF THAT CERTAIN 13.24 ACRE PARCEL SHOWN ON
R.S. 20-162, S.J.C.R.

SURVEYOR'S STATEMENT

This Corner Record was prepared by me or under my direction in conformance with the Land Surveyors' Act on Feb 16, 2000.



Signed Michael L. Quarteroni L.S. or R.C.E. Number 4450

COUNTY SURVEYOR'S STATEMENT

This Corner Record was received Feb. 17, 2000 and examined and filed February 23,, 2000.

Signed Henry M. Hirata R.C.E. No. 21258
Title County Surveyor

County Surveyors Comment _____

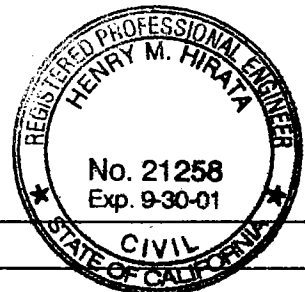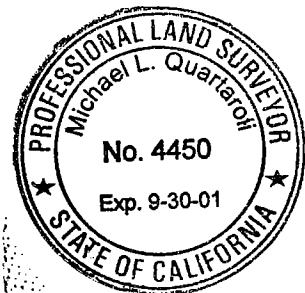



References

(A) Indicates Record of Survey Book 20, page 162, S.J.C.R.

Legend

- Indicates Found Monument As Noted
- Indicates set 3/4" x 30" Iron Pipe Tagged LS 4450
- (M) Indicates measured
- R.S. Indicates Record of Survey, Book and Page, S.J.C.R.

Scale: 1" = 200'

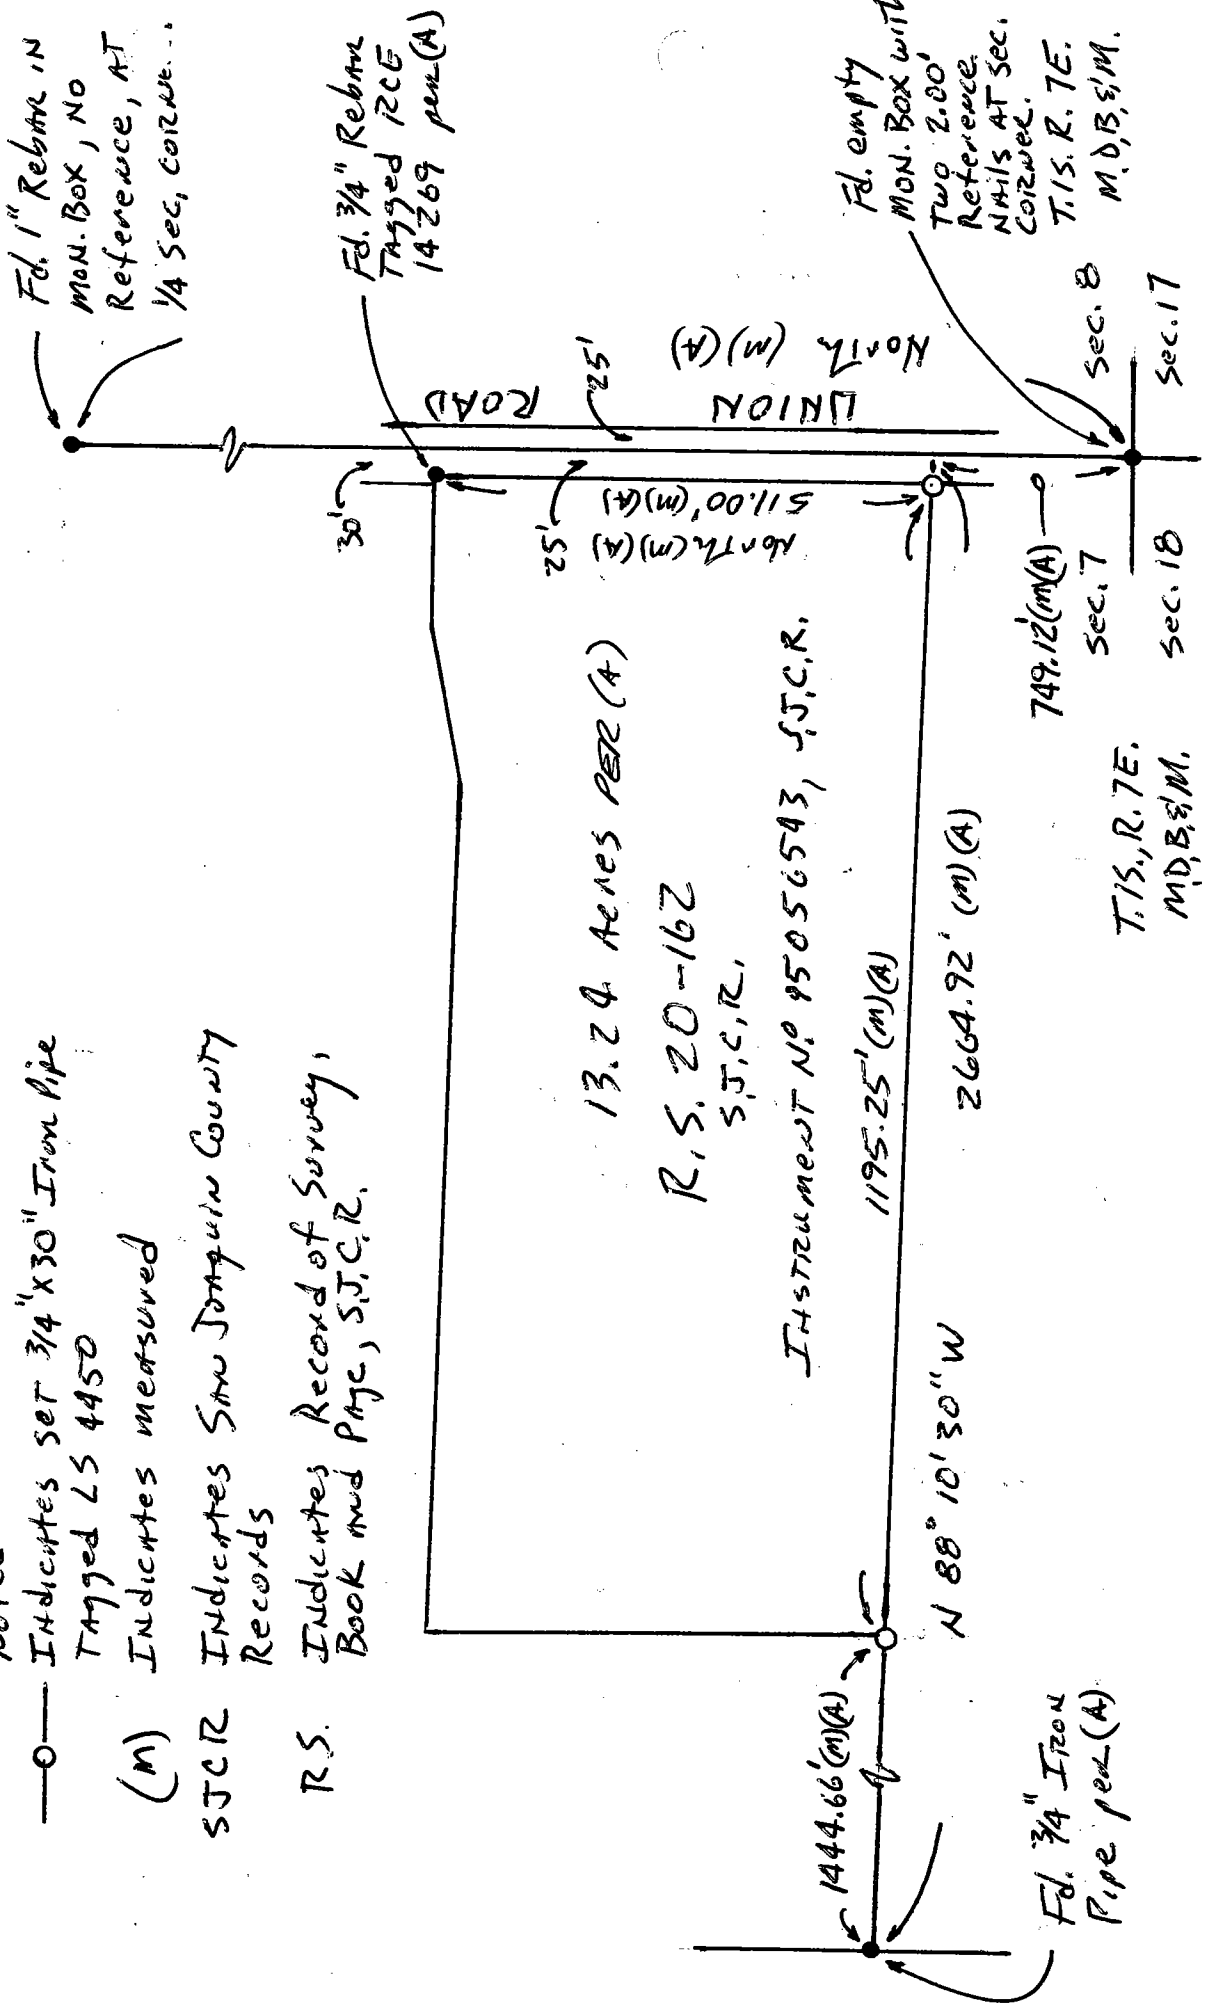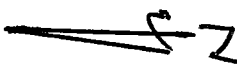





