

CORNER RECORD


City of Ripon

Document Number 00-152
County of San Joaquin, California

Brief Legal Description Centerline of Road monument at Prospect Road and Ridge Road, Ripon, Per M.E.P. 7-13, San Joaquin County Records

CORNER TYPE

COORDINATES (Optional)

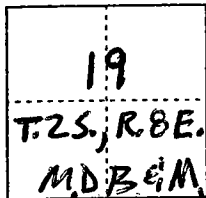

Government Corner ☐ Control ☐
Meander ☐ Property ☐
Rancho ☐ Other ☒

Date of Survey Dec. 18, 1999

N. _____
E. _____
Zone _____ NAD27 ☐ NAD83 ☐
NAD83 Epoch _____
Elev. _____
Vert. Datum: NGVD29 ☐ NAVD88 ☐
Meas. Units: Metric ☐ Imperial ☒

Corner - Left as found ☐ Found and tagged ☐ Established ☐ Reestablished ☐ Rebuilt ☒

Identification and type of corner found: Evidence used to identify or procedure used to establish or reestablish the corner:

Found monument as noted on sketch on reverse side.

A description of the physical condition of the monument as found and as set or reset:

See sketch on reverse side.

SURVEYOR'S STATEMENT

This Corner Record was prepared by me or under my direction in conformance with the Land Surveyors' Act on Feb 16, 2000.

Signed Michael L. Quarles or R.C.E. Number 4450

COUNTY SURVEYOR'S STATEMENT

This Corner Record was received Feb. 17, 2000 and examined and filed February 23, 2000.

Signed Henry M. Hirata R.C.E. No. 21258


Title _____ County Surveyor

County Surveyors Comment _____





Scale: 1" = 40'

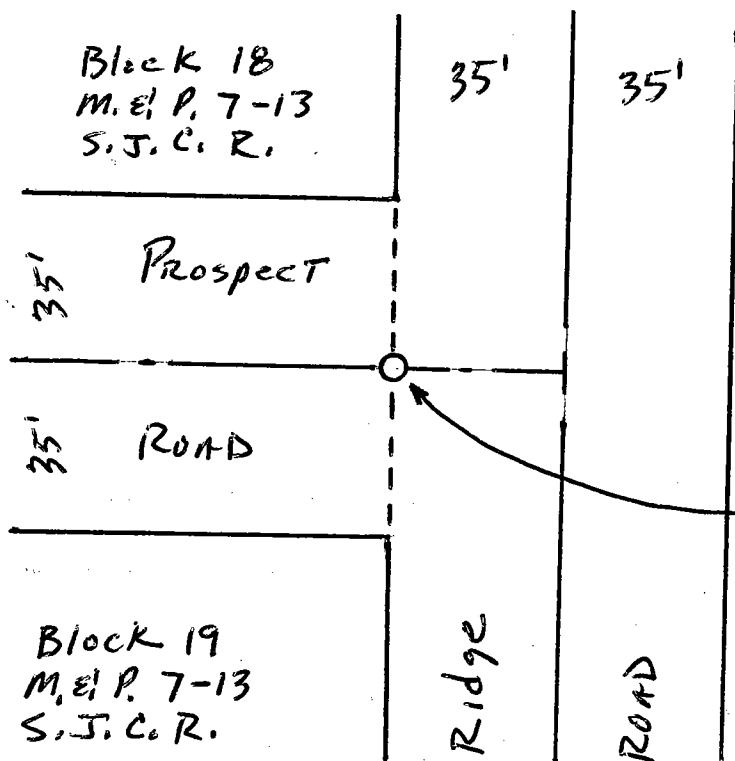

Found Railroad spike
per P.M. 5-152, S.J.C.R.
0.3' deep. Found $\frac{1}{2}$ " Iron
pipe 1.3' deep. Top half
of pipe bent easterly
and bottom half of pipe
was straight. Accepted
as being "Iron Pipe"
per M. & P. 7-13, S. J. C. R.
Removed $\frac{1}{2}$ " Iron Pipe
and re-set with $\frac{3}{4}$ " x 30"
Iron pipe tagged L.S. 4450.

Legend

- M. & P. Indicates Maps and
Plats, San Joaquin
County Records
- S. J. C. R. Indicates San Joaquin
County Records