


CORNER RECORD

City of Stockton

Document Number 00-242
County of San Joaquin, California

Brief Legal Description PARCELS 2 & 3, Book 12 of Parcel Maps, Pg. 52, San Joaquin County Records

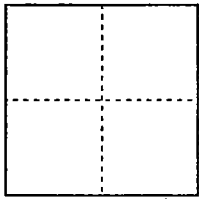

CORNER TYPE

Government Corner Control
Meander Property
Rancho Other
Date of Survey 3/9/00

COORDINATES (Optional)

N. _____
E. _____
Zone _____ NAD27 NAD83
NAD83 Epoch _____
Elev. _____
Vert. Datum: NGVD29 NAVD88
Meas. Units: Metric Imperial

Corner - Left as found Found and tagged Established Reestablished Rebuilt

Identification and type of corner found: Evidence used to identify or procedure used to establish or reestablish the corner:

See other side

A description of the physical condition of the monument as found and as set or reset:

see other side

SURVEYOR'S STATEMENT

This Corner Record was prepared by me or under my direction in conformance with the Land Surveyors' Act on JUNE 2, 192000.


Signed Stephen R. Thumlert L.S. or R.C.E. Number 4334



COUNTY SURVEYOR'S STATEMENT

This Corner Record was received AUGUST 15, 2000, and examined and filed AUGUST 21, 2000.

Signed Manuel Lopez R.C.E. No. 28054
Title _____ County Surveyor

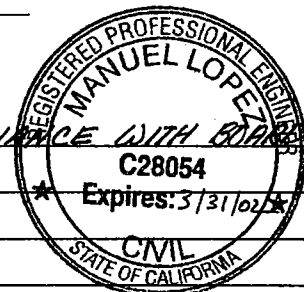

County Surveyor's Comment CORNER RECORD IS NOT IN COMPLIANCE WITH BOARD RULE 464(C) REGARDING DATE OF SUBMITTAL.

(D.D. Sheet No. 31A)

LEGEND

- FD. 1" I. PIPE, TAGGED "RCE 1014" PER M.&P. 16-22
- SET SPIKE & 1 1/2" WASHER STAMPED "LS 4334 & SURVEY MARK"
- S.J.C.R. DENOTES SAN JOAQUIN COUNTY RECORDS
- M.&P. DENOTES BOOK OF MAPS AND PLATS WITH BOOK AND PAGE, S.J.C.R.
- P.M. DENOTES PARCEL MAP WITH BOOK & PAGE, S.J.C.R.
- (CALC.) DENOTES CALCULATIONS FROM RECORD DATA PER (R2) WHICH ALSO EQUALS MEASURED DATA
- (R2) DENOTES RECORD DATA FROM M. & P. 16-22

NOTE: A SEARCH WAS MADE FOR MONUMENTS AT ALL CORNERS OF PARCELS 1-11 AND 27-28 AND FOUND NOTHING EXCEPT AS SHOWN ON MAP.

UNIT NO. 6, SHERWOOD MANOR, M.&P. 16-22

