


CORNER RECORD

Document Number 00-294

City of STOCKTON County of SAN JOAQUIN, California

Brief Legal Description BOOK 32 OF SURVEYS, PAGE 49, SAN JOAQUIN COUNTY RECORDS.

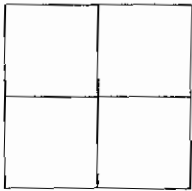

CORNER TYPE

Government Corner  Control   
Meander  Property   
Rancho  Other   
Date of Survey 10-27-00

COORDINATES (Optional)

N. 2150130.108  
E. 6329875.75  
Zone 3 NAD27  NAD83   
NAD83 Epoch 1991.35  
Elev. 8.72  
Vert. Datum: NGVD29  NAVD88   
Meas. Units: Metric  Imperial

Corner - Left as found  Found and tagged  Established  Reestablished  Rebuilt

Identification and type of corner found: Evidence used to identify or procedure used to establish or reestablished the corner:  
BRASS DISK STAMPED "10S-12" LS 4334 IN MONUMENT BOX MARKING THE CITY OF STOCKTON  
CONTROL MONUMENT AT THE INTERSECTION OF WOLFE ROAD EAST AND SOUTH AS SHOWN FOR RECORD  
IN BOOK 32 OF SURVEYS AT PAGE 49, SAN JOAQUIN COUNTY RECORDS WAS DESTROYED DUE TO THE  
RECONSTRUCTION OF FRENCH CAMP ROAD. MONUMENT WAS RE-ESTABLISHED USING THE SWING TIES  
SET PRIOR TO THE MONUMENT BEING DESTROYED AS SHOWN ON PREVIOUS CORNER RECORD 00-289.

A description of the physical condition of the monument as found and as set or reset:  
SET 2 1/2" BRASS DISK STAMPED "10S-12", "9-2000", "LS 6953", AND "CITY OF STOCKTON SURVEY  
MONUMENT" IN MONUMENT WELL.

SURVEYOR'S STATEMENT

This Corner Record was prepared by me or under my direction in conformance with the Land Surveyors' Act on OCTOBER 31, 2000.

Signed [Signature] L.S. Number 6953




COUNTY SURVEYOR'S STATEMENT

This Corner Record was received NOVEMBER 1, 2000 and examined and filed NOVEMBER, 2000.

Signed [Signature] R.C.E. No. 28054  
Title County Surveyor



County Surveyors Comment

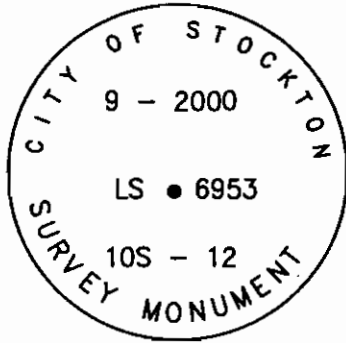

DISK STAMPING



NOT TO SCALE

