

CORNER RECORD


City of _____

Document Number 01-55
County of San Joaquin, California

Brief Legal Description A PORTION OF THE N 1/2 OF SECTION 36, TOWNSHIP 3 NORTH, RANGE 9 EAST, MOUNT DIABLO MERIDIAN AS SHOWN IN BOOK 20 OF SURVEYS, PAGE 131, S.J.C.R.

CORNER TYPE

COORDINATES (Optional)

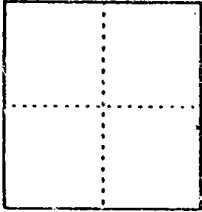

Government Corner Control
Meander Property
Rancho Other

Date of Survey DECEMBER 29, 2000

N. _____
E. _____
Zone _____ NAD27 NAD83
NAD83 Epoch _____
Elev. _____
Vert. Datum: NGVD29 NAVD88
Meas. Units: Metric Imperial

Corner - Left as found Found and tagged Established Reestablished Rebuilt

Identification and type of corner found: Evidence used to identify or procedure used to establish or reestablish the corner:

FOUND A 3/4" IRON PIPE ON SHELTON ROAD PER RECORD OF SURVEY BOOK 20, PAGE 131 PIPE UNTAGGED; ATTACHED TAG L.S. 5443 AND LEFT AS FOUND.

A description of the physical condition of the monument as found and as set or reset: FOUND MONUMENT IN GOOD CONDITION.

SURVEYOR'S STATEMENT

This Corner Record was prepared by me or under my direction in conformance with the Land Surveyors' Act on DECEMBER 29, 2000.


Signed David Lee Harris L.S. or R.C.E. Number 5443



COUNTY SURVEYOR'S STATEMENT

This Corner Record was received JAN. 26, 2001 and examined and filed: February 28, 2001.


Signed Manuel Lopez R.C.E. No. 28054
Title County Surveyor

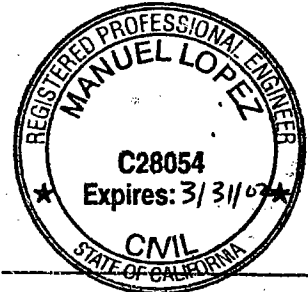

County Surveyors Comment _____



SCALE: 1"=200'

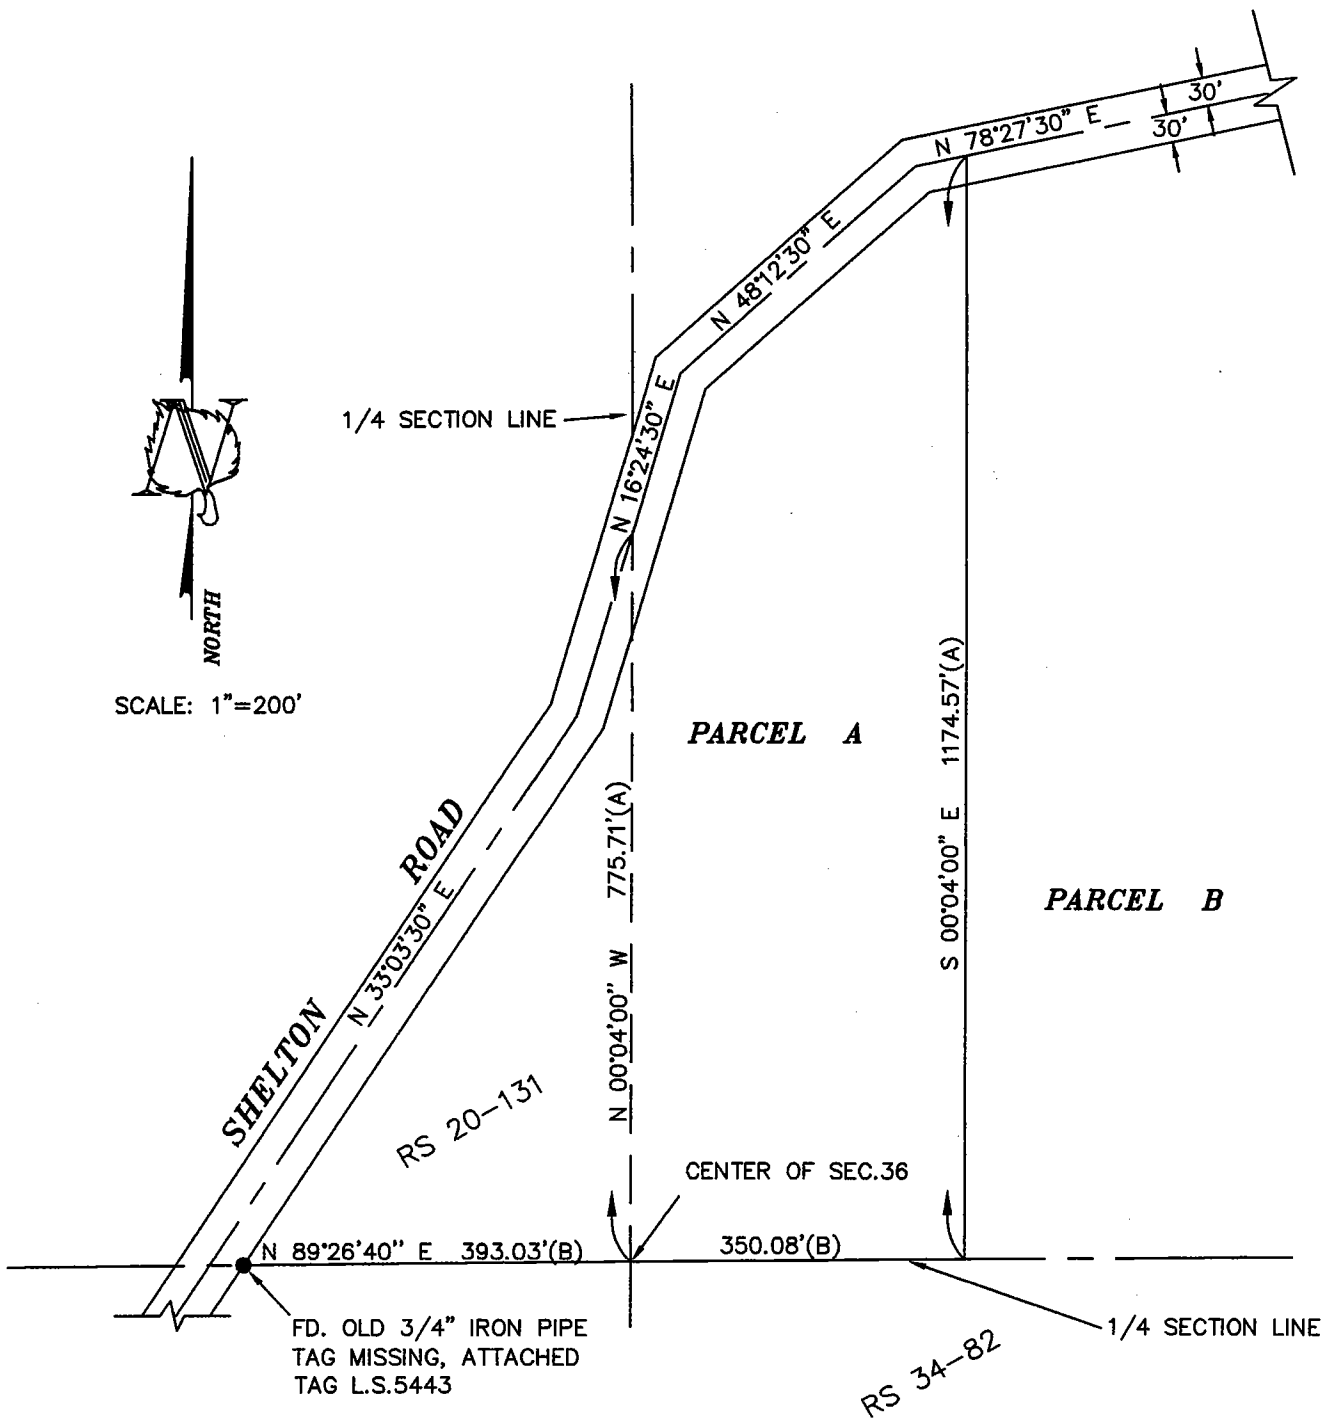

LEGEND :

- (A) - RECORD OF SURVEY, BOOK 20, PAGE 131, S.J.C.R.
- (B) - RECORD OF SURVEY, BOOK 34, PAGE 82, S.J.C.R.
- S.J.C.R. - SAN JOAQUIN COUNTY RECORDS
- RS - RECORD OF SURVEY



ASPEN SURVEY COMPANY

1121 OAKDALE RD., STE. 6 MODESTO, CA. 95355
 PH: (209) 526 9724 PH: (800) 526 9724
 FX: (209) 526 0472