

CORNER RECORD


City of Lodi

Document Number 01-82
County of San Joaquin, California

Brief Legal Description RM 70 = Caltrans project control survey monument.
T3N, R6E, MDB&M

CORNER TYPE

COORDINATES (Optional)

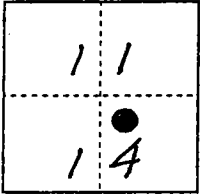

Government Corner Control
Meander Property
Rancho Other
Date of Survey 10-3-00

N. _____
E. _____
Zone _____ NAD27 NAD83
NAD83 Epoch _____
Elev. _____
Vert. Datum: NGVD29 NAVD88
Meas. Units: Metric Imperial

Corner - Left as found Found and tagged Established Reestablished Rebuilt

Identification and type of corner found: Evidence used to identify or procedure used to establish or reestablish the corner:

Found Caltrans brass disk stamped "70" in survey well per State Highway Monument Map "55-12-PM 16 1/2 / 18.1."

A description of the physical condition of the monument as found and as set or reset:

Monument found in good condition.

SURVEYOR'S STATEMENT

This Corner Record was prepared by me or under my direction in conformance with the Land Surveyors' Act on 10-3, 2000.


Signed Ira G. Pearson, Jr. L.S. or R.C.E. Number 7396

COUNTY SURVEYOR'S STATEMENT

This Corner Record was received FEB. 28, 2001 and examined and filed MARCH 5, 2001.

Signed Manuel Lopez R.C.E. No. 28054
Title County Surveyor

County Surveyors Comment _____

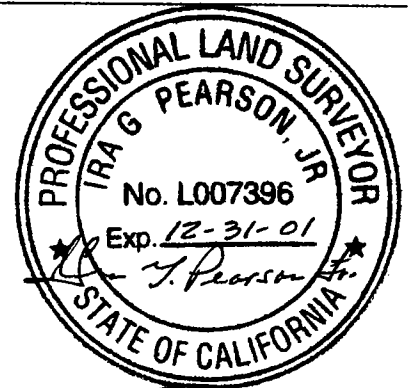


(D.D. Sheet No. 15)

Set PK in sidewalk joint at center of sidewalk at MOC.

Set PK in gutter joint at MOC.

NOTE:
All PK swing ties are with "Caltrans" brass tag.

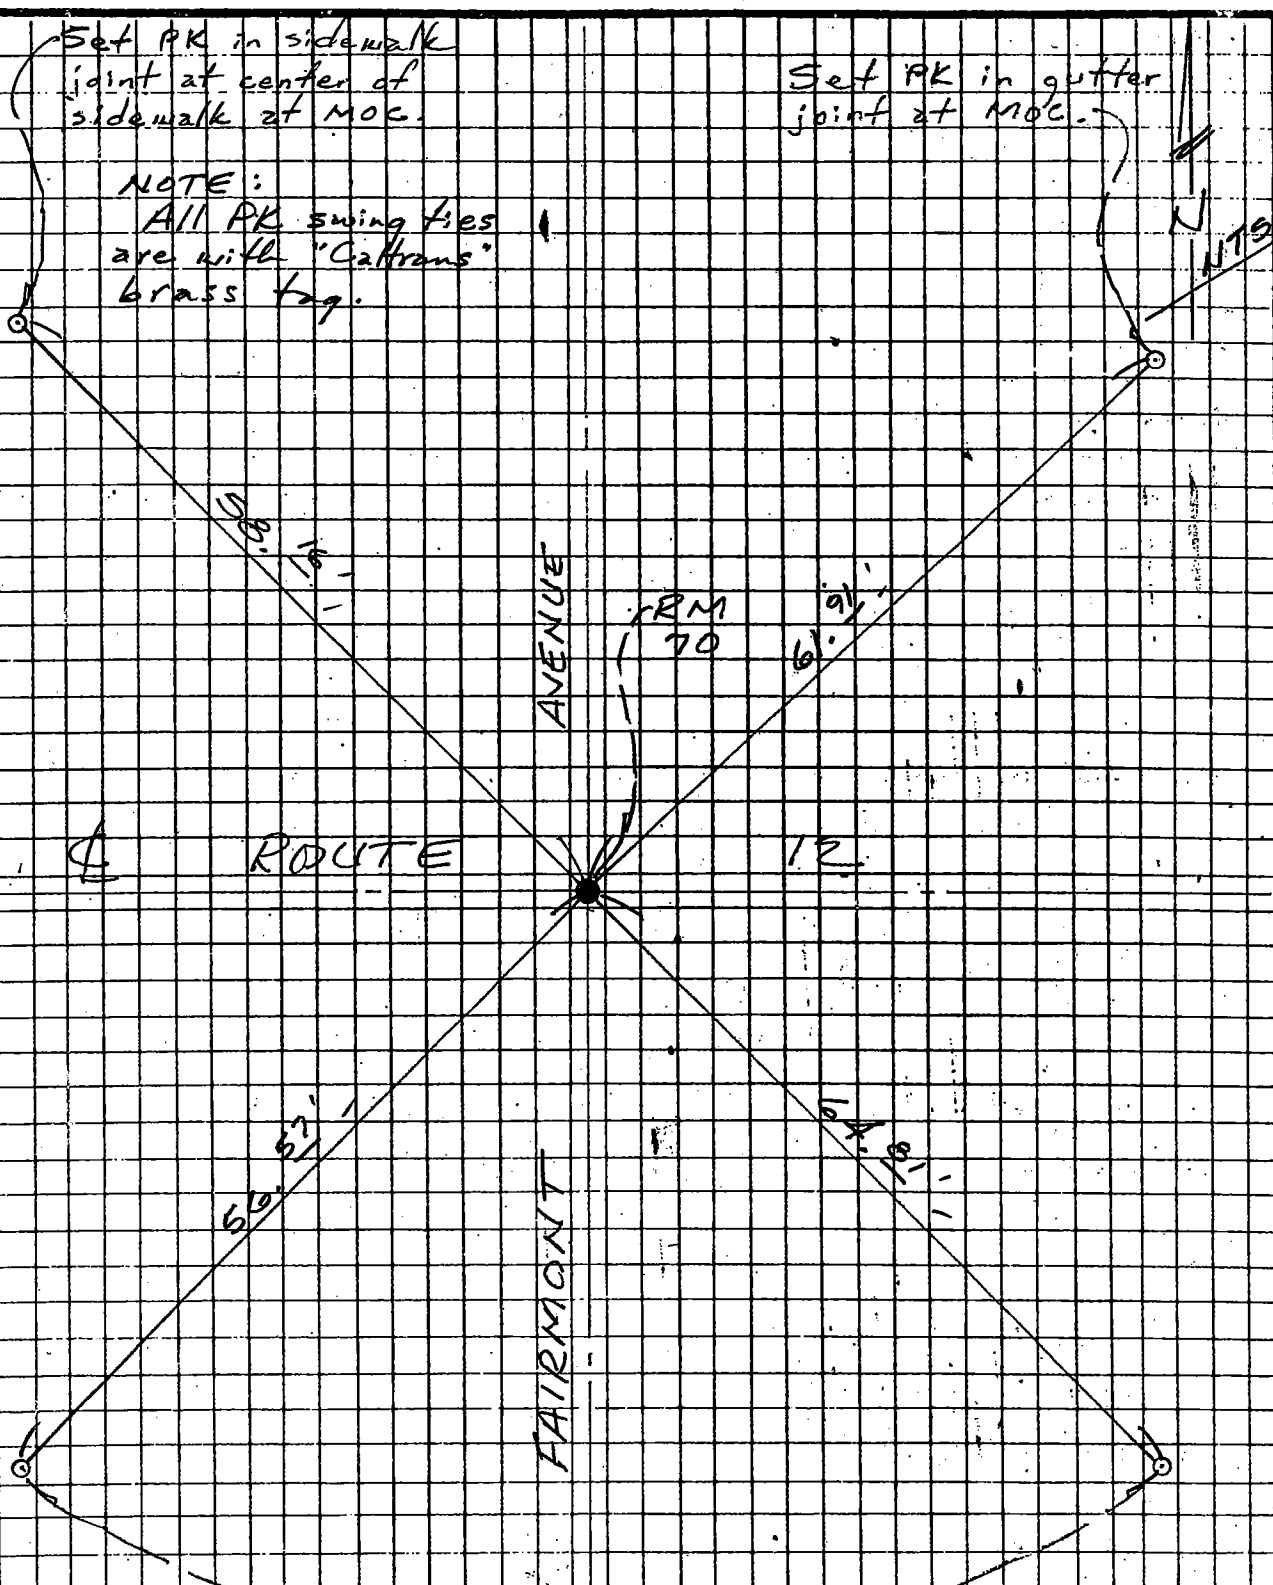

ROUTE

AVENUE

FAIRMONT

IRM 70

12

50' 57"


61' 91"


Set PK in curb joint at back of curb at ECR of Route 12.