


# CORNER RECORD

Document Number 01-102

City of TRACY County of SAN JOAQUIN, California

Brief Legal Description 12th STREET AT HOLLY DRIVE

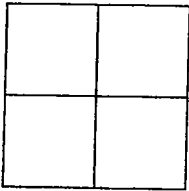

Government Corner  Control   
Meander  Property   
Rancho  Other   
Date of Survey 2-27-01

### COORDINATES (Optional)

N. \_\_\_\_\_  
E. \_\_\_\_\_  
Zone \_\_\_\_\_ NAD27  NAD83   
NAD83 Epoch \_\_\_\_\_  
Elev. \_\_\_\_\_  
Vert. Datum: NGVD29  NAVD88   
Meas. Units: Metric  Imperial


Corner - Left as found  Found and tagged  Established  Reestablished  Rebuilt

Identification and type of corner found: Evidence used to identify or procedure used to establish or reestablished the corner:  
FOUND 1 1/2" IRON PIPE NOT TAGGED ON 12th STREET APPROXIMATELY 15 FEET WEST OF  
THE CENTERLINE OF HOLLY DRIVE.

A description of the physical condition of the monument as found and as set or reset:  
FOUND 1 1/2" IRON PIPE WILL BE DESTROYED DUE TO PAVEMENT RECONSTRUCTION.  
SET NAILS TAGGED LS6953 AS SHOWN ON SKETCH.

This Corner Record was prepared by me or under my direction in conformance with the Land Surveyors' Act on April 4, 2001.

Signed [Signature] L.S. 6953

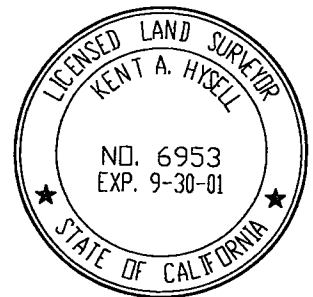

### COUNTY SURVEYOR'S STATEMENT

This Corner Record was received APRIL 4, 2001 and examined and filed APRIL 9, 2001.

Signed [Signature] R.C.E. No. 28054  
Title County Surveyor



County Surveyors Comment \_\_\_\_\_

