


CORNER RECORD

City of Stockton

Document Number 01-109
County of San Joaquin, California

Brief Legal Description NW Corner of Lot 33, Normandy Provence Unit No. 2, M&P 22-98, San Joaquin County Records.

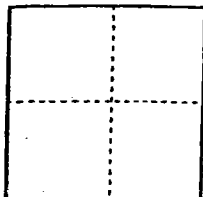

CORNER TYPE

- Government Corner Control
- Meander Property
- Rancho Other

Date of Survey 3-18-98

COORDINATES (Optional)

N. _____
 E. _____
 Zone _____ NAD27 NAD83
 NAD83 Epoch _____
 Elev. _____
 Vert. Datum: NGVD29 NAVD88
 Meas. Units: Metric Imperial

Corner - Left as found Found and tagged Established Reestablished Rebuilt

Identification and type of corner found: Evidence used to identify or procedure used to establish or reestablish the corner:
Chis "+" Re-established using found Chis "+" at Southwest corner of Lot 33, with Found Right of way 3/4" Iron Pin, no tag at the North west corner of Lot 36 of Normandy Provence Unit No. 2, M&P 22-98

A description of the physical condition of the monument as found and as set or reset: Reset 5' offset Chis "+" at the North west corner of Lot 33, Normandy Provence Unit No. 2, M&P 22-98

SURVEYOR'S STATEMENT

This Corner Record was prepared by me or under my direction in conformance with the Land Surveyors' Act on March 27, 2000.


Signed Michael David Jones L.S. or R.C.E. Number 6173

COUNTY SURVEYOR'S STATEMENT

This Corner Record was received JULY 2, 2001 and examined and filed JULY 19, 2001.

Signed Thomas M. Gau R.C.E. No. 26994
Title County Surveyor

County Surveyor's Comment Corner Record is not in compliance with Rule 464(c).

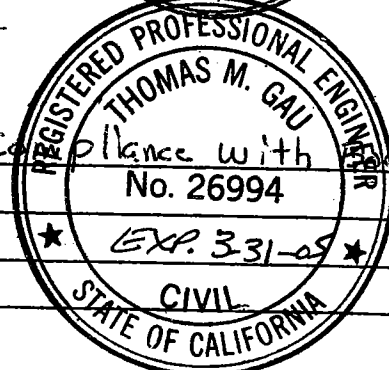

CHERBOURG

FND. 3/4" I. PIN IN
MON. WELL PER M&P
22-98, NO TAG

WAY

NO CHIS "+" FD.

FD. 3/4" I. PIN,
(M&P 22-98), NO
TAG

59

FD. CHIS "+" ON
5' LOT LINE
PROJECTION

DRIVE

30'

30'

36

237.89'

60

177.89'

35

N08°38'25"E

FD. CHIS "+" ON
5' LOT LINE
PROJECTION

341.23'

34

RESET CHIS "+"
5' ON LOT LINE
PROJECTION

SCALE: 1"=50'



61

62
NORMANDY PROVENCE
UNIT NO. 2
M&P 22-98

FD. CHIS "+" ON
5' LOT LINE
PROJECTION

33

60.00'

32

63

FND. 3/4" I. PIN IN
MON. WELL PER M&P
22-88, NO TAG

BURGUNDY

N08°38'25"E

S81°21'35"E
(RADIAL)

23

NORMANDY PROVENCE
UNIT NO. 1
M&P 22-88

FD. CHIS "+" ON
LOT LINE
PROJECTION

30'

30'

25

24

NOTE: FOUND CROSSES NOT
OF RECORD.

BASIS OF BEARINGS:
CENTERLINE MONUMENTS ON BURGUNDY DRIVE AS
SHOWN ON M&P 22-98 BEARING N08°38'25"E