


CORNER RECORD

Document Number 02-13
County of San Joaquin, California

City of N/A

Brief Legal Description Record of Survey 23-83

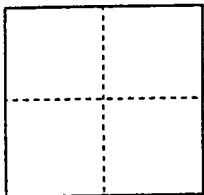

CORNER TYPE

- Government Corner Control
- Meander Property
- Rancho Other

Date of Survey 4/4/99

COORDINATES (Optional)

N. _____
 E. _____
 Zone _____ NAD27 NAD83
 NAD83 Epoch _____
 Elev. _____
 Vert. Datum: NGVD29 NAVD88
 Meas. Units: Metric Imperial

Corner - Left as found Found and tagged Established Reestablished Rebuilt


Identification and type of corner found: Evidence used to identify or procedure used to establish or reestablish the corner:
Found 3/4" iron rod, no tag. I did not file this corner record in conformance with Board Rule 464(c) regarding time of when the monument was found as I had no anticipation of it being destroyed.

A description of the physical condition of the monument as found and as set or reset: _____

SURVEYOR'S STATEMENT

This Corner Record was prepared by me or under my direction in conformance with the Land Surveyors' Act on March 1, 2002.

Signed [Signature] L.S. ~~XXXXX~~ Number 7269

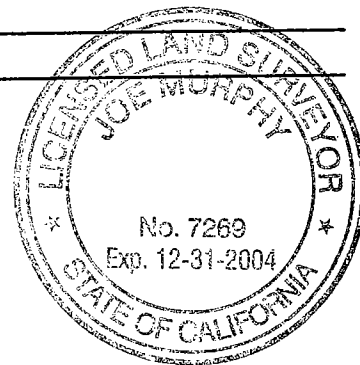

COUNTY SURVEYOR'S STATEMENT

This Corner Record was received MARCH 1, 2002 and examined and filed MARCH 5, 2002.

Signed [Signature] L.S. R.C.E. No. 4440
 Title ASSISTANT County Surveyor

County Surveyors Comment _____

(D.D. Sheet No. 11)

STATE HIGHWAY 99

KENNEFICK RD.

40' R/W

FD 3/4" I.R. (R4)
WITH NO TAG.

3434.53' (M)
N 88°42'24" W

FD. BOLT
(R1) AT
1/4 SEC.
CORNER

SECTION
LINE

SEC. 18
T.4 N., R.7 E.

SEC. 17

S 00°46'47" E
2648.0' (R3)(M)

40' R/W

PELTIER RD.

SEC. 19

SEC. 20

FD. BOLT AND WASHER
(R1) AT SEC. CORNER,
STAMPED LS 2239. (R2)

LEGEND

- FD FOUND
- I.R. IRON ROD
- R/W RIGHT-OF-WAY
- (M) MEASURED
- MONUMENT FOUND (AS NOTED)
- PM PARCEL MAP
- CR CORNER RECORD
- RS RECORD OF SURVEY

REFERENCES

- (R1) PM 18-107
- (R2) CR 01-48
- (R3) RS 6-202
- (R4) RS 23-83

SCALE: N 1" = 300'

