


CORNER RECORD

City of N/A

Document Number 02-14
County of San Joaquin, California

Brief Legal Description Record of Survey 23-83

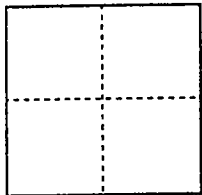

CORNER TYPE

Government Corner Control
Meander Property
Rancho Other

Date of Survey 4/4/99

COORDINATES (Optional)

N. _____
E. _____
Zone _____ NAD27 NAD83
NAD83 Epoch _____
Elev. _____
Vert. Datum: NGVD29 NAVD88
Meas. Units: Metric Imperial

Corner - Left as found Found and tagged Established Reestablished Rebuilt


Identification and type of corner found: Evidence used to identify or procedure used to establish or reestablish the corner:
Found 3/4" iron rod, no tag. I did not file this corner record in conformance with Board
Rule 464(c) regarding time of when the monument was found as I had no anticipation
of it being destroyed.

A description of the physical condition of the monument as found and as set or reset: _____

SURVEYOR'S STATEMENT

This Corner Record was prepared by me or under my direction in conformance with
the Land Surveyors' Act on March 1, 2002.

Signed Joe Murphy L.S. No. 7269

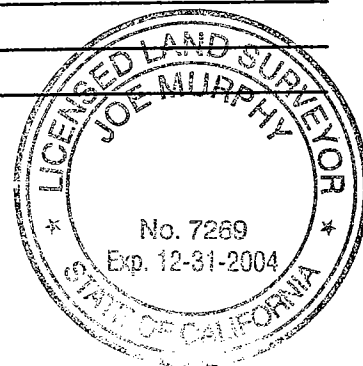

COUNTY SURVEYOR'S STATEMENT

This Corner Record was received MARCH 1, 2002 and examined
and filed MARCH 5, 2002.

Signed Jeff Lund L.S. No. 4440

Title ASSISTANT County Surveyor

County Surveyors Comment _____

(D.D. Sheet No. 11)

STATE HIGHWAY 99

KENNEFICK RD.

FD 3/4" I.R. (R4)
WITH NO TAG.

3699.10' (M)
N 88°42'24" W

40' R/W

FD. BOLT
(R1) AT
1/4 SEC.
CORNER

SECTION
LINE

SEC. 18
T.4 N., R.7 E.

SEC. 17

S 00°46'47" E
2648.0' (R3)(M)

40' R/W

PELTIER RD.

SEC. 19

SEC. 20

FD. BOLT AND WASHER
(R1) AT SEC. CORNER,
STAMPED LS 2239. (R2)

LEGEND

FD FOUND
 I.R. IRON ROD
 R/W RIGHT-OF-WAY
 (M) MEASURED
 • MONUMENT FOUND
 (AS NOTED)
 PM PARCEL MAP
 CR CORNER RECORD
 RS RECORD OF SURVEY

REFERENCES

(R1) PM 18-107
 (R2) CR 01-48
 (R3) RS 6-202
 (R4) RS 23-83

SCALE: N 1" = 300'

