


**CORNER RECORD**

City of N/A

Document Number 02-16  
County of San Joaquin, California

Brief Legal Description Record of Survey 23-83

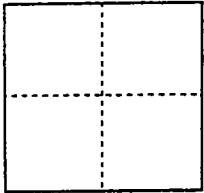

**CORNER TYPE**

Government Corner  Control   
Meander  Property   
Rancho  Other   
Date of Survey 4/4/99

**COORDINATES (Optional)**

N. \_\_\_\_\_  
E. \_\_\_\_\_  
Zone \_\_\_\_\_ NAD27  NAD83   
NAD83 Epoch \_\_\_\_\_  
Elev. \_\_\_\_\_  
Vert. Datum: NGVD29  NAVD88   
Meas. Units: Metric  Imperial

Corner - Left as found  Found and tagged  Established  Reestablished  Rebuilt


Identification and type of corner found: Evidence used to identify or procedure used to establish or reestablish the corner:  
Found 3/4" iron rod, no tag. I did not file this corner record in conformance with Board Rule 464(c) regarding time of when the monument was found as I had no anticipation of it being destroyed.

A description of the physical condition of the monument as found and as set or reset: \_\_\_\_\_

**SURVEYOR'S STATEMENT**

This Corner Record was prepared by me or under my direction in conformance with the Land Surveyors' Act on March 1, 2002.

Signed Joe Murphy L.S. ~~XXXXXX~~ Number 7269

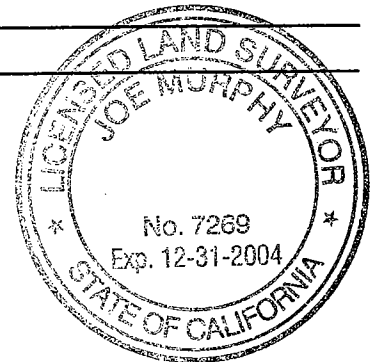

**COUNTY SURVEYOR'S STATEMENT**

This Corner Record was received MARCH 1, 2002 and examined and filed MARCH 5, 2002.

Signed Jeff Gaud L.S. No. 4440  
Title ASSISTANT County Surveyor

County Surveyors Comment \_\_\_\_\_

STATE HIGHWAY 99

KENNEFICK RD.

40' R/W

FD 3/4" I.R. (R4)  
AT 1/4, 1/4 SEC.  
WITH NO TAG.

3963.67' (M)  
N 88°42'24" W

FD. BOLT  
(R1) AT  
1/4 SEC.  
CORNER

SECTION  
LINE

SEC. 18  
T.4 N., R.7 E.

S 00°46'47" E  
2648.0' (R3)(M)

SEC. 17

40' R/W

PELTIER RD.

SEC. 19

SEC. 20

FD. BOLT AND WASHER  
(R1) AT SEC. CORNER,  
STAMPED LS 2239. (R2)

LEGEND

- FD FOUND
- I.R. IRON ROD
- R/W RIGHT-OF-WAY
- (M) MEASURED
- MONUMENT FOUND (AS NOTED)
- PM PARCEL MAP
- CR CORNER RECORD
- RS RECORD OF SURVEY

REFERENCES

- (R1) PM 18-107
- (R2) CR 01-48
- (R3) RS 6-202
- (R4) RS 23-83

SCALE:  1" = 300'