


CORNER RECORD

City of N/A

Document Number 02-28
County of San Joaquin, California

Brief Legal Description Record of Survey 21-168

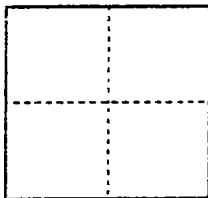

CORNER TYPE

Government Corner Control
Meander Property
Rancho Other

Date of Survey July 5, 2001

COORDINATES (Optional)

N. _____
E. _____
Zone _____ NAD27 NAD83
NAD83 Epoch _____
Elev. _____
Vert. Datum: NGVD29 NAVD88
Meas. Units: Metric Imperial

Corner - Left as found Found and tagged Established Reestablished Rebuilt


Identification and type of corner found: Evidence used to identify or procedure used to establish or reestablish the corner.
Reset corner as shown in the location indicated on corner record 02-18.

A description of the physical condition of the monument as found and as set or reset: Set 3/4" x 30"
iron rod capped and stamped L.S. 7269.

SURVEYOR'S STATEMENT

This Corner Record was prepared by me or under my direction in conformance with
the Land Surveyors' Act on April 5, 2002.

Signed [Signature] L.S. or R.C.E. Number 7269

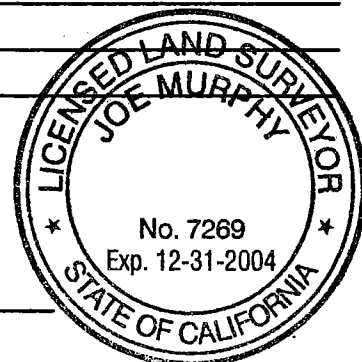

COUNTY SURVEYOR'S STATEMENT

This Corner Record was received APRIL 10, 2002 and examined
and filed APRIL 17, 2002.

Signed [Signature] P.L.S. No. 4440

Title Assistant County Surveyor



County Surveyor's Comment _____

SEC. 8

SEC. 9

50' R/W

JAHANT RD.

FD. S.J. CO. MON. BOLT
AT SEC. CORNER (R1) AND
WASHER, STAMPED L.S. 2239

SEC. 17
T.4N., R.7E.

SEC. 16

SCALE: N 1" = 300'

SECTION LINE

FD. PK NAIL
(NO RECORD)

S 00°52'00" E 748.49'

S 74°25'53" W 1024.97' (M)
75°17'53" (M)

SET 3/4" I.R.
CAPPED L.S. 7269.
SET IN PLACE AS SHOWN
ON CORNER RECORD 02-18
ON FILE WITH THE SAN JOAQUIN
COUNTY SURVEYORS OFFICE

DUSTIN RD.

S 00°52'00" E 1608.58' (M)

40' R/W

FD S.J. CO. MON.
BRASS BOLT AND WASHER
AT 1/4 SEC. CORNER (R2)
STAMPED LS 2239

LEGEND

- FD FOUND
- I.R. IRON ROD
- R/W RIGHT-OF-WAY
- (M) MEASURED
- MONUMENT FOUND
- PM PARCEL MAP
- RS RECORD OF SURVEY
- MONUMENT SET (AS NOTED)

REFERENCES

- (R1) PM 6-26
- (R2) PM 18-107
- (R3) RS 21-168