


CORNER RECORD

Document Number CR-02-49
City of --- County of San Joaquin, California

Brief Legal Description Northeasterly corner of Parcel P, Fairchild Industrial Park, P.M. 6-134

 

CORNER TYPE

Government Corner ☐ Control ☐
Meander ☐ Property ☒
Rancho ☐ Other ☐

Date of Survey 9/11/02

COORDINATES (Optional)

N. _____
E. _____
Zone _____ NAD27 ☐ NAD83 ☐
NAD83 Epoch _____
Elev. _____
Vert. Datum: NGVD29 ☐ NAVD88 ☐
Meas. Units: Metric ☐ Imperial ☐

Corner - Left as found ☐ Found and tagged ☐ Established ☐ Reestablished ☒ Rebuilt ☐

Identification and type of corner found: Evidence used to identify or procedure used to establish or reestablish the corner:


See other side

A description of the physical condition of the monument as found and as set or reset: N/A

SURVEYOR'S STATEMENT

This Corner Record was prepared by me or under my direction in conformance with the Land Surveyors' Act on September 25, 2002.

Signed Stephen R. Thumbert L.S. Number 4334

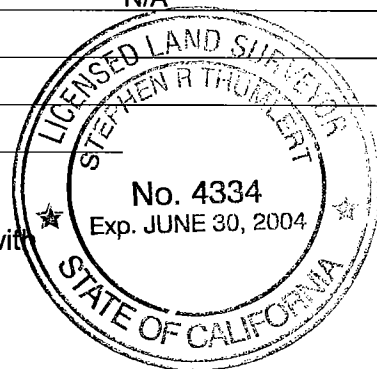

COUNTY SURVEYOR'S STATEMENT

This Corner Record was received OCTOBER 4, 2002 and examined and filed OCTOBER 7, 2002.

Signed J.D. Lund P.L.S. No. 4440

Title Assistant County Surveyor



County Surveyor's Comment _____

(D.D. Sheet No. 33)

—●— denotes 1 d. 3/4" I. Pin, tagged "R.C.E.
 8189" per P.M. 6-134
 —○— denotes 1 d. 3/4" I. Pin, tagged "R.C.E.
 8189" per P.M. 6-134 in Mon.
 Well.

(R) denotes record data from P.M. 6-134
 SFN Searcher, Fd. Nothing

