

CORNER RECORD

City of Lodi Document Number 02-53
County of San Joaquin, California

Brief Legal Description Lower Sacramento Road at St. Moritz Drive

CORNER TYPE

Government Corner Control
 Meander Property
 Rancho Other

Date of Survey 8/8/99

COORDINATES (Optional)

N. _____
 E. _____
 Zone NAD27 NAD83
 NAD83 Epoch _____
 Elev. _____
 Vert. Datum: NGVD29 NAVD88
 Meas. Units: Metric Imperial

Corner - Left as found Found and tagged Established Reestablished Rebuilt

Identification and type of corner found: Evidence used to identify or procedure used to establish or reestablish the corner:


Found ¼ inch iron rod in monument box at the intersection of Lower Sacramento Road and St. Moritz Drive

A description of the physical condition of the monument as found and as set or reset: The monument is in good condition. Reference point was set in case monument is disturbed.

SURVEYOR'S STATEMENT

This Corner Record was prepared by me or under my direction in conformance with the Land Surveyors' Act on November 15, 2002.

Signed *Terry Piazza* ~~LS~~ R.C.E. Number 19638

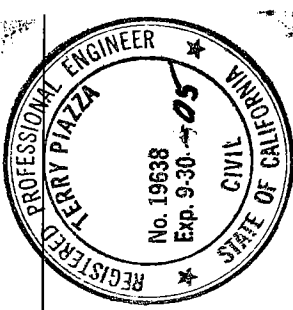

COUNTY SURVEYOR'S STATEMENT

This Corner Record was received DECEMBER 27, 2002 and examined and filed JANUARY 3, 2003.

Signed *Jeff D. Lund*




Title Assistant County Surveyor P.L.S. No. 4440

County Surveyor's Comment This corner record is not in compliance with Board Rule 464(c) regarding submittal within 90 days from the date of survey.

LEGEND

SEC.	SECTION
FD.	FOUND
⊙	FD. 3/4" IRON ROD TAGGED R.C.E. 12685 IN MONUMENT BOX PER M&P 27-92
M.&P.	BOOK OF MAPS AND PLATS

ALL REFERENCES ARE TO SAN JOAQUIN COUNTY RECORDS AND BOOK OR VOLUME PRECEDES PAGE.

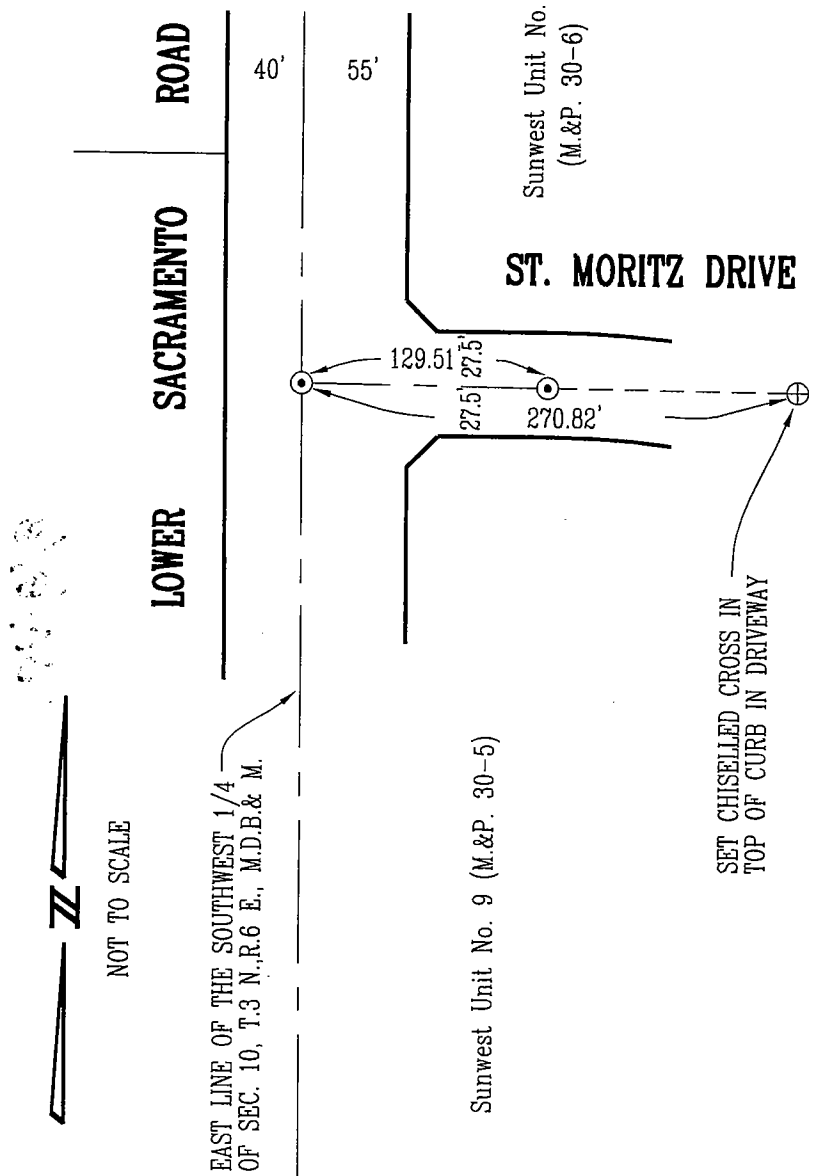

NOTE:

THE TIES SHOWN HEREON ARE FOR THE PURPOSE OF PERPETUATING THE MONUMENTATION CURRENTLY EXISTING. NO ATTEMPT WAS MADE TO DETERMINE THE VALIDITY OF THE MONUMENTS OR THEIR PROPER LOCATION IN RELATION TO LEGAL BOUNDARY LINES IN THE AREA.