
CORNER RECORD

	Document Number <u>O2 - 58</u>
City of Lodi	County of <u>San Joaquin</u> ,California
Brief Legal Description Lower Sacramento Road at F	Paradise Drive
CORNER TYPE	COORDINATES (Optional)
Government Corner Control	N
Meander Droperty	☐ ZoneNAD27 ☐ NAD83 ☐
Rancho 🛘 Other	X NADOS EPOCH
Date of Survey	Elev Vert. Datum: NGVD29 NAVD88
2010 01 001 VO)	Meas. Units: Metric 🏻 Imperial 🗎
Corner - Left as found x Found and tagged □	Established Reestablished Rebuilt
Identification and type of corner found: Evidence used to identify o	r procedure used to establish or reestablish the corner.
Found ¾ inch iron rod in monument box per Maps and Plats	
Dood and Davidso Drive	
Road and Paradise Drive	
A description of the physical condition of the monument as found	and as set or reset: The monument is in good
condition. Reference point was set in case monument is dis	turbed.
SURVEYOR'S STATEMENT	PROFESSION
This Corner Record was prepared by me or under my direct	ion in conformance with
the Land Surveyors Act on November 15	2002
	\\\\\\\\\\\\\\\\\\\\\\\\\\\\\\\\\\\\\\
Signed	R.C.E. Number 19638
COUNTY SURVEYOR'S STATEMENT	OF CALIFORNIA
This Corner Record was received	7, 200 Z and examined
and filed	EF D. LUS
	P.L.S. No. 4440
Title Assistant County Surveyor	* 930 <u>05</u> *
County Surveyor's Comment This corner record is r	not in compliance
with Board Rule 464(c) regarding submittal within 90 days fr	om the date of
survey.	
(D.D. Sheet No. <u>15-A</u>)	

Borpels-12□7

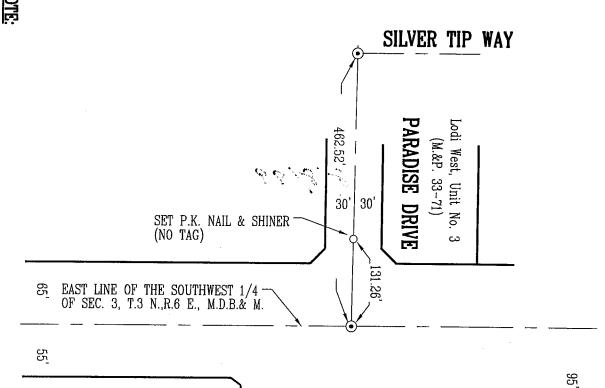

LOWER SACRAMENTO ROAD

NOT TO SCALE

FD. FOUND

FD. FOUND

FD. 3/4" IRON ROD TAGGED R.C.E. 19638 IN MONUMENT BOX PER M.&P. 33-71

SET MONUMENT, AS NOTED M.&P. BOOK OF MAPS AND PLATS ALL REFERENCES ARE TO SAN JOAQUIN COUNTY RECORDS AND BOOK OR VOLUME PRECEDES PAGE.