


CORNER RECORD

Document Number 03-11

City of RIPON County of SAN JOAQUIN, California

Brief Legal Description BOOK 32 OF SURVEYS, PAGE 163, SAN JOAQUIN COUNTY RECORDS.

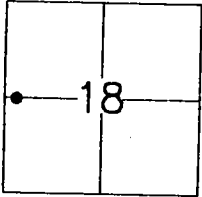

CORNER TYPE

Government Corner Control
 Meander Property
 Rancho Other
 Date of Survey 9-23-02

COORDINATES (Optional)

N. _____
 E. _____
 Zone _____ NAD27 NAD83
 NAD83 Epoch _____
 Elev. _____
 Vert. Datum: NGVD29 NAVD88
 Meas. Units: Metric Imperial

Corner - Left as found Found and tagged Established Reestablished Rebuilt

Identification and type of corner found: Evidence used to identify or procedure used to establish or reestablished the corner:
FOUND 3/4" IRON PIPE, TAGGED L.S. 5402.

THIS PIPE WAS SET FOR THE PROPERTY CORNER ON R.S. 32-163.


A description of the physical condition of the monument as found and as set or reset: _____
FOUND MONUMENT IN GOOD CONDITION, SEE SKETCH ON BACK.

THE MONUMENT WILL BE DESTROYED DUE TO STREET IMPROVEMENTS FOR THE CHESAPEAKE PROJECT.

SURVEYOR'S STATEMENT

This Corner Record was prepared by me or under my direction in conformance with the Land Surveyors' Act on NOVEMBER 25, 2002.

Signed [Signature] L.S. Number 6953

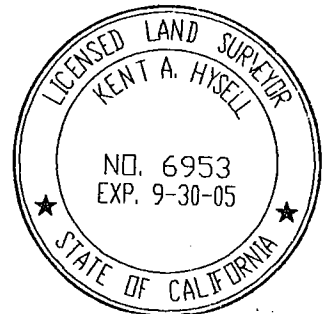

COUNTY SURVEYOR'S STATEMENT

This Corner Record was received February 12, 200~~2~~³ and examined and filed February 14, 2003.

Signed [Signature] P.L.S. No. 4440

Title Assistant County Surveyor



County Surveyors' Comment _____

SET N&S IN
POWER POLE,
LINE ONLY

SET PK NAIL
AND TAG L.S. 6953

SECTION AND RANGE LINE

191.00'

JACK TONE ROAD

SET PK NAIL
AND TAG L.S. 6953

155.00'

SCALE: 1" = 60'

LEGEND:

N&S NAIL AND SHINER,
STAMPED L.S. 6953

⊗ POWER POLE

APPROXIMATE
WEST 1/4 COR
SECTION 18
T. 2 S., R. 8 E.,
M.D.B. & M.

1/4 SECTION LINE

FOUND 3/4" IRON PIPE,
TAGGED L.S. 5402,
PER R.S. 32-163

