


CORNER RECORD

Document Number 04-02

City of STOCKTON County of SAN JOAQUIN, California

Brief Legal Description BOOK 28 OF SURVEYS, PAGE 180, SAN JOAQUIN COUNTY RECORDS.

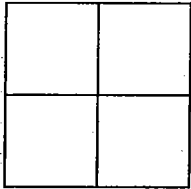

CORNER TYPE

Government Corner Control
Meander Property
Rancho Other
Date of Survey 2-6-03

COORDINATES (Optional)

N. 2200960.34
E. 6332655.79
Zone 3 NAD27 NAD83
NAD83 Epoch 1991.35
Elev. 21.03
Vert. Datum: NGVD29 NAVD88
Meas. Units: Metric Imperial

Corner - Left as found Found and tagged Established Reestablished Rebuilt

Identification and type of corner found: Evidence used to identify or procedure used to establish or reestablished the corner:
FOUND BRASS DISK STAMPED "4N-7" RCE 8189 IN MONUMENT BOX MARKING THE CITY OF STOCKTON CONTROL MONUMENT AS SHOWN FOR RECORD IN BOOK 28 OF SURVEYS AT PAGE 180, SAN JOAQUIN COUNTY RECORDS PRIOR TO BEING DESTROYED.

COORDINATES SHOWN ABOVE ARE BASED ON BOOK 35 OF SURVEYS AT PAGE 5. ELEVATION SHOWN IS BASED ON THE CITY OF STOCKTON PUBLISHED BENCHMARK LISTING REVISED MARCH 2000.

A description of the physical condition of the monument as found and as set or reset:
THE MONUMENT WILL BE DESTROYED DUE TO THE CONSTRUCTION OF A WATER LINE ALONG WEST LANE. SET REFERENCE POINTS AS SHOWN ON SKETCH.

SURVEYOR'S STATEMENT

This Corner Record was prepared by me or under my direction in conformance with the Land Surveyors' Act on DECEMBER 10, 2003.

Signed [Signature] L.S. 6953




COUNTY SURVEYOR'S STATEMENT

This Corner Record was received January 20, 2004 and examined and filed JANUARY 26, 2004.

Signed [Signature] P.L.S. No. 4440

Title Assistant County Surveyor

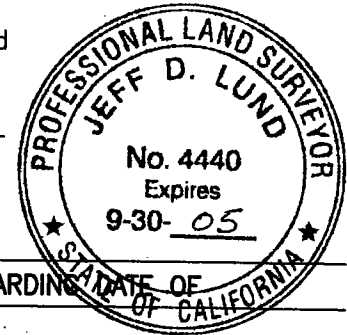

County Surveyor's Comment

THIS CORNER RECORD DOES NOT COMPLY WITH BOARD RULE 464(c) REGARDING SUBMITTAL.

WEST LANE

NOT TO SCALE

MORADA LANE

FD. BRASS DISK IN MONUMENT WELL
R.C.E. 8189
CITY OF STOCKTON
SURVEY MONUMENT
4N-7

SET SCRIBED "+"
ON MEDIAN ISLAND
TBM ELEV. 23.455

EXISTING MEDIAN ISLAND

SET NAIL & TAG
LS 6953

SET SCRIBED "+"
ON SIDEWALK

EXISTING SIDEWALK

