

CORNER RECORD

Document Number


04-04

City of STOCKTON

County of SAN JOAQUIN

, California

Brief Legal Description BOOK 34 OF SURVEYS, PAGE 88, SAN JOAQUIN COUNTY RECORDS.

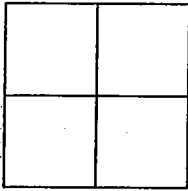

CORNER TYPE

Government Corner [] Control []
Meander [] Property [X]
Rancho [] Other []
Date of Survey 12-23-03

COORDINATES (Optional)

N.
E.
Zone NAD27 [] NAD83 []
NAD83 Epoch
Elev.
Vert. Datum: NGVD29 [] NAVD88 []
Meas. Units: Metric [] Imperial []

Corner - Left as found [] Found and tagged [] Established [] Reestablished [X] Rebuilt []


Identification and type of corner found: Evidence used to identify or procedure used to establish or reestablished the corner:
3/4" IRON PIPES TAGGED RCE 15831 ALONG THE SOUTH LINE OF THE SURVEY AS SHOWN
FOR RECORD IN BOOK 34 OF SURVEYS AT PAGE 88, SAN JOAQUIN COUNTY RECORDS WERE
DESTROYED DUE TO THE CONSTRUCTION OF A SEWER AND WATER LINE. MONUMENTS WERE
RE-ESTABLISHED USING THE SWING TIES SET PRIOR TO THE MONUMENTS BEING DESTROYED AS
SHOWN ON PREVIOUS CORNER RECORD 04-03.

A description of the physical condition of the monument as found and as set or reset:
SET 3/4" IRON PIPE TAGGED "LS 6953" OR AS NOTED.

SURVEYOR'S STATEMENT

This Corner Record was prepared by me or under my direction in conformance with the Land Surveyors' Act on JANUARY 16, 2004.

Signed [Signature] L.S. Number 6953

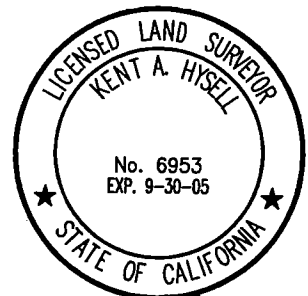

COUNTY SURVEYOR'S STATEMENT

This Corner Record was received January 27, 2004 and examined and filed JANUARY 28, 2004.

Signed [Signature] P.L.S. No. 4440
Title Assistant County Surveyor



County Surveyors Comment

POINT "F"
FOUND 3/4" IRON PIN
TAGGED R.C.E. 15831

| POINT | ANGLE RIGHT TURNING FROM BASE PT. "G" USING BASELINE PT. "G" TO PT. "F" | MEASURED DISTANCE |
|-------|---|-------------------|
| "A" | 11°10'54" | 43.94' |
| "B" | 306°49'51" | 567.58' |
| "C" | 306°35'52" | 637.32' |
| "E" | 302°43'01" | 947.08' |
| "F" | 00°00'00" | 2558.07' |
| "G" | 00°00'00" | 00.00' |

| POINT | ANGLE RIGHT TURNING FROM BASE PT. "E" USING BASELINE PT. "E" TO PT. "G" | MEASURED DISTANCE |
|-------|---|-------------------|
| "A" | 357°29'10" | 931.85' |
| "B" | 353°53'57" | 383.13' |
| "C" | 352°06'33" | 314.19' |
| "D" | 193°01'38" | 411.78' |
| "E" | 00°00'00" | 00.00' |
| "G" | 00°00'00" | 947.08' |

RS 34-88

WEST LANE

NOT TO SCALE

POINT "C"
SET 3/4" IRON PIPE
TAGGED LS 6953

POINT "D"
SET 3/4" IRON PIPE
TAGGED LS 6953

714.13'(M) 714.10'(R1)

69.78'(M) CHORD
69.80'(R1) CHORD

POINT "B"
SET 3/4" IRON PIPE
TAGGED LS 6953

549.99'(M)
550.00'(R1)

POINT "A"
SET 3/4" IRON PIPE
TAGGED LS 6953

MORADA LANE

POINT "E"
FOUND 1/2" IRON PIPE
L.S. 6953
CONTROL PT.

POINT "G"
SET NAIL & TAG LS 6953
USING SWING TIES AS
SHOWN ON CORNER
RECORD 04-02.

REFERENCES:

(M) MEASURED THIS SURVEY

(R1) RECORD DATA PER R.S. 34-88 S.J.C.R.

S.J.C.R. SAN JOAQUIN COUNTY RECORDS