


CORNER RECORD

Document Number 04-08  
County of San Joaquin, California

City of Unincorporated Area

Brief Legal Description Intersection of Orange St. and Mokelumne St., NE  
1/4, Sec. 34, T. 4 N., R. 6 E., M.D.M.

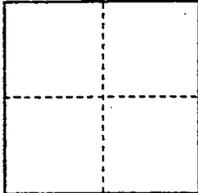

CORNER TYPE

- Government Corner  Control
- Meander  Property
- Rancho  Other

Date of Survey 11/24/03

COORDINATES (Optional)

N. \_\_\_\_\_  
 E. \_\_\_\_\_  
 Zone \_\_\_\_\_ NAD27  NAD83   
 NAD83 Epoch \_\_\_\_\_  
 Elev. \_\_\_\_\_  
 Vert. Datum: NGVD29  NAVD88   
 Meas. Units: Metric  Imperial

Corner - Left as found  Found and tagged  Established  Reestablished  Rebuilt

Identification and type of corner found: Evidence used to identify or procedure used to establish or reestablish the corner:

Utilized ties from corner record, date of survey 2/25/03. CR-03-46

A description of the physical condition of the monument as found and as set or reset:

Set 5/8" rebar with plastic cap, stamped "MTCO LS 5978"  
in monument well.

SURVEYOR'S STATEMENT

This Corner Record was prepared by me or under my direction in conformance with the Land Surveyors' Act on December 30, 2003.


Signed My Stanley L.S. ~~XXXX~~ Number LS 5978



COUNTY SURVEYOR'S STATEMENT

This Corner Record was received January 12, 2004 and examined and filed FEBRUARY 5, 2004.

Signed Jeff Lund L.S. No. 4440  
Title ASSISTANT County Surveyor

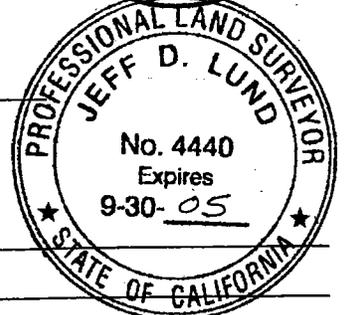

County Surveyor's Comment \_\_\_\_\_

(D.D. Sheet No. 12A )

