


CORNER RECORD

Document Number 04-17

City of RIPON

County of SAN JOAQUIN, California

Brief Legal Description KEY AVENUE AS SHOWN ON THE RECORD OF SURVEY, BOOK 32 OF SURVEYS, AT PAGE 54, S.J.C.R.

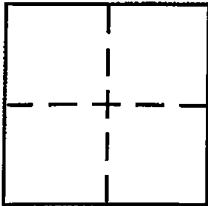

CORNER TYPE

Government Corner Control
 Meander Property
 Rancho Other
 Date of Survey 4-16-02

COORDINATES (Optional)

N. _____
 E. _____
 Zone _____ NAD27 NAD83
 NAD83 Epoch _____
 Elev. _____
 Vert. Datum: NGVD29 NAVD88
 Meas. Units: Metric Imperial

Corner - Left as found Found and tagged Established Reestablished Rebuilt

Identification and type of corner found: Evidence used to identify or procedure used to establish or reestablish the corner:

SEE SKETCH ON BACKSIDE

A description of the physical condition of the monument as found and as set or reset:

SEE SKETCH ON BACKSIDE

SURVEYOR'S STATEMENT

This Corner Record was prepared by me or under my direction in conformance with the Land Surveyor's Act on JULY 9, 2004

Signed Dylan Crawford P.L.S. or R.C.E. No. 7788




COUNTY SURVEYOR'S STATEMENT

This Corner Record was received JULY 13, 2004

and examined and filed JULY 16, 2004

Signed Jeff D. Lund P.L.S. or R.C.E. No. 4440

Title ASSISTANT COUNTY SURVEYOR

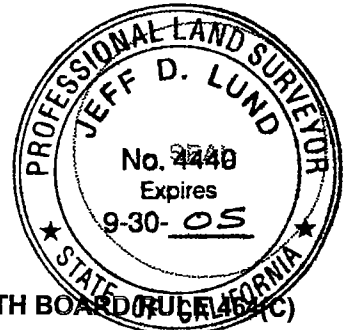

County Surveyor's Comment THIS CORNER RECORD IS NOT IN COMPLIANCE WITH BOARD RULE 46(C) REGARDING SUBMITTAL WITHIN 90 DAYS FROM THE DATE OF SURVEY.

LEGEND

—⊙— FD. 3/4" REBAR W/ CAP STAMPED L.S. 5230

—+— SET SCRIBED "+" IN SIDEWALK

(R1) - BOOK 32 OF SURVEYS, AT
PAGE 54, S.J.C.R.

