


**CORNER RECORD**

City of Stockton

Document Number 04-33  
County of San Joaquin, California

Brief Legal Description Lot 82, Swain Oaks Manor, Maps and Plats Book 11, Page 115, San Joaquin County Records

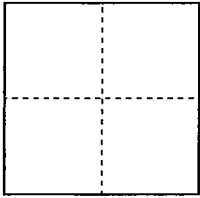

**CORNER TYPE**

Government Corner Control  
Meander Property \*  
Rancho Other  
Date of Survey 9/20/2004

**COORDINATES (Optional)**

N. \_\_\_\_\_  
E. \_\_\_\_\_  
Zone \_\_\_\_\_ NAD27 NAD83  
NAD83 Epoch \_\_\_\_\_  
Elev. \_\_\_\_\_  
Vert. Datum: NGVD29 NAVD88  
Meas. Units: Metric Imperial \*

Corner - Left as found Found and tagged Established \* Reestablished Rebuilt

Identification and type of corner found: Evidence used to identify or procedure used to establish or reestablish the corner:

Established witness monument for the Northwest corner of Lot 82 per M. & P. 11-115, S.J.C.R. Fd. Old chiseled cross at the Northeast corner of Lot 82 & the northeast corner of Lot 86. Measured distance between found monuments fit record distance.


A description of the physical condition of the monument as found and as set or reset:

Set chiseled cross for witness corner of Northwest corner Lot 82.

**SURVEYOR'S STATEMENT**

This Corner Record was prepared by me or under my direction in conformance with the Land Surveyors' Act on October 1, 2004.

Signed Walter John Shoup L.S. ~~NO. 7736~~ Number 7736

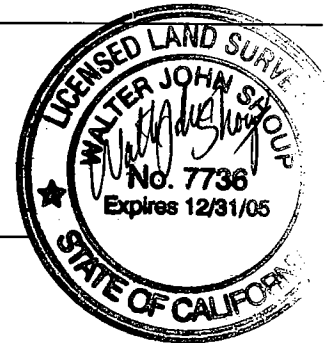

**COUNTY SURVEYOR'S STATEMENT**

This Corner Record was received OCTOBER 1, 2004 and examined and filed OCTOBER 8, 2004.

Signed J.D. Lund P.L.S. No. 4440

Title Assistant County Surveyor



County Surveyor's Comment \_\_\_\_\_



LEGEND:

M. & P. MAPS AND PLATS BOOK-PAGE, S.J.C.R.

S.J.C.R. SAN JOAQUIN COUNTY RECORDS

(R1) M.& P. 11-115, S.J.C.R.

SCALE: 1' = 50'

