
| CORNER RECORD | | | 4 | | | |
|--|---|---|--------------------------|---------------------------------|--|--|
| City of | | | Document Nu County of | miler <u>04</u> San Joaquin, | | |
| • | on DUNCAN ROAD 3969': | | 2045 | | 211211 | |
| | NW 1/4 OF SECTION 22, 1 | | THO TO | | | |
| | CO | C | COORDINATES (Optional) | | | |
| | Government Corne | er ⊠ Control □ | N | NAD2 | | |
| 22 | Meander Come | □ Property □ | Zone | NAD2 | 7 □ NAD83 □ | |
| | Rancho | □ Other □ | NAD83 Epo Elev | ocn | | |
| | Date of Survey <u>Ju</u> | ne 4, 2002 | Vert. Datu | m: NGVD29 🗆 | NAVD88 ☐ Imperial ⊠ | |
| Corner - Left as | found 🛭 Found and to | ıgged □ Establishe | ed 🗌 Reestabl | ished □ Ret | ouilt 🔲 | |
| | | | | | | |
| A description of the | physical condition of the i | monument as found ar EE SKETCH ON BACKSIDI | F | | | |
| ibio Course D | Surveyor's statem | | | PROFESS/ | 000 | |
| he Land Surveyors | ras prepared by me or un Act on <u>Dec.</u> 9 | | nformance with | No. C3089 | CHOINEEN. | |
| | | , 2004. | | No. C3089 | o NE | |
| igned Manue | dodorio | R.C.E. Number <u>C308</u> | 90 | 3/31/20 | 06/食// | |
| | County surveyor's st | | | OF CALIF | ORALL. | |
| his Corner Record and filed | was received DEC CEMBER 14 | <u>. 13</u> , 2004 and , 2004. | d examined | Manuel | Mar | |
| igned | Inty Surveyor | P.L.S. No | 4440 | ESONAL LA ESOUF D. | LUND SUBJECTION AND SESSION AND SUBJECTION AND SUBJ | |
| County Surveyor's C HIS CORNER RECORE | Comment | WITH BOARD RULE 464(| c) | No. 44 | 440 A | |
| EGARDING SUBMITTA | L WITHIN 90 DAYS FROM T | HE DATE OF SURVEY. | | 9-30-0 | S X | |

(D.D. Sheet Nos. 24 & 25)

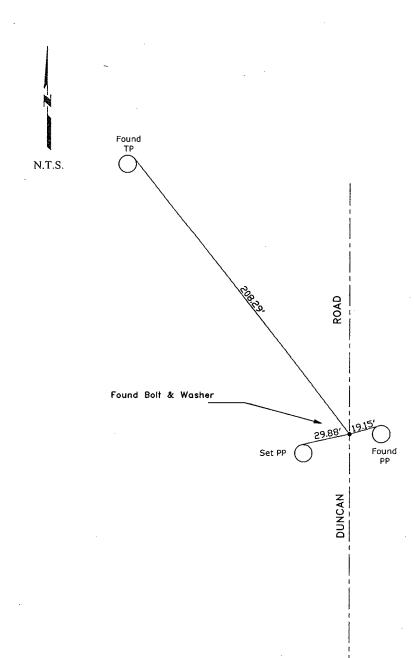

"No Attempt Was Made to Verify Monument(s)"

FP=Fence Post
GP=Guy Post
JP=Joint Pole
PP=Power Pole
SP=Service Pole
TP=Telephone Pole
N.T.S.=Not to Scale
Sel=Conc. Nails with Brass Washers Stamped
"S.J. Co.". unless otherwise noted
Found=Nail with Shiner, unless otherwise noted
Note: Found Monuments are not Tagged nor of
Record unless otherwise noted.