


CORNER RECORD

Document Number 05-03

City of TRACY

County of SAN JOAQUIN, California

Brief Legal Description LOTS 22 AND 60 OF M. & P. 37-17

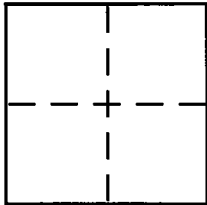

CORNER TYPE

Government Corner Control
Meander Property
Rancho Other
Date of Survey 12-02-04

COORDINATES (Optional)

N. _____
E. _____
Zone _____ NAD27 NAD83
NAD83 Epoch _____
Elev. _____
Vert. Datum: NGVD29 NAVD88
Meas. Units: Metric Imperial

Corner - Left as found Found and tagged Established Reestablished Rebuilt

Identification and type of corner found: Evidence used to identify or procedure used to establish or reestablish the corner:

SEE SKETCH ON BACK.

A description of the physical condition of the monument as found and as set or reset: _____

MONUMENT SET OF DIFFERENT CHARACTER THAN SHOWN ON RECORD MAP FOR TRACT NO. 3230, 37 M & P 17. FOR SOUTHERLY FRONT CORNERS OF LOTS 22 AND 60.

SURVEYOR'S STATEMENT

This Corner Record was prepared by me or under my direction in conformance with the Land Surveyor's Act on JANUARY 10, 2005

Signed _____ (P.L.S. or R.C.E. No. 5412)

COUNTY SURVEYOR'S STATEMENT


This Corner Record was received JANUARY 12, 2005

and examined and filed JANUARY 18, 2005

Signed Jeff Lund (P.L.S. or R.C.E. No. 4440)

Title ASSISTANT COUNTY SURVEYOR

County Surveyor's Comment _____

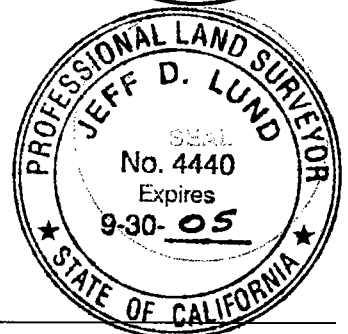

- LEGEND:**
- PL - M PROPERTY LINE TO MONUMENT.
 - M - M MONUMENT TO MONUMENT.
 - M & P MAPS AND PLATS.
 - ⊙ FD. 2 1/2" BRASS DISC STAMPED "LS 5412" IN MONUMENT WELL PER M & P 37-17.
 - FD. 3/4" IRON PIPE TAGGED LS 5412 @ PROPERTY CORNERS OR AS NOTED.
 - + FD. CUT CROSS PER M & P 37-17.

