


CORNER RECORD

Document Number 05-19

City of N/A

County of SAN JOAQUIN, California

Brief Legal Description INTERIOR QUARTER CORNER OF SECTION 15, T. 2 S., R. 9 E., M.D.B. & M.

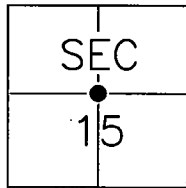

CORNER TYPE

Government Corner Control
 Meander Property
 Rancho Other

COORDINATES(Optional)

N. _____
 E. _____
 Zone _____ NAD27 NAD83
 NAD83 Epoch _____
 Elev. _____
 Vert. Datum: NGVD29 NADV88
 Meas. Units: Metric Imperial

Date of Survey APRIL 27, 2005

Corner - Left as found Found and tagged Established Reestablished Rebuilt

Identification and type of corner found: Evidence used to identify or procedure used to establish or reestablish the corner:

IRON PIN AND WASHER IN MONUMENT WELL PER BOOK 16 OF PARCEL MAPS, PAGE 101, SAN JOAQUIN COUNTY RECORDS, WAS DESTROYED WITH THE CONSTRUCTION OF A TUNNEL FOR A CONVEYOR SYSTEM. CORNER WAS REESTABLISHED USING TIES SHOWN ON FILED CORNER RECORD, CR-05-02. SEE FOLLOWING PAGE FOR LOCATION OF TIES.


A description of the physical condition of the monument as found and as set or reset _____

SET MONUMENT IS A 3/4" IRON PIPE TAGGED L.S. 4895 SET IN NEW MONUMENT WELL.

SURVEYOR'S STATEMENT

This Corner Record was prepared by me or under my direction in conformance with the Land Surveyor's Act on MAY 5, 2005.

Signed [Signature] P.L.S. or R.C.E. No.: L.S. 4895

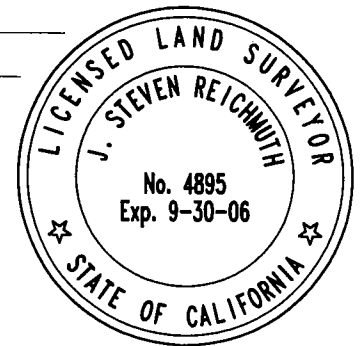

COUNTY SURVEYOR'S STATEMENT

This Corner Record was received JULY 1, 2005, and examined and filed JULY 5, 2005.

Signed [Signature] P.L.S. or R.C.E. No.: 4440

Title Assistant County Surveyor

County Surveyor's Comment _____



CORNER RECORD

