


CORNER RECORD

Document Number 05 - 23

City of STOCKTON

County of SAN JOAQUIN, California

Brief Legal Description BEING A PORTION OF SECTION 57 C.M. WEBER GRANT

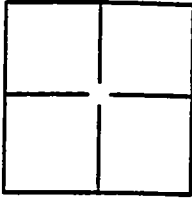

CORNER TYPE

Government Corner Control
 Meander Property
 Rancho Other

Date of Survey JULY 15, 2005

COORDINATES(Optional)

N. _____
 E. _____
 Zone _____ NAD27 NAD83
 NAD83 Epoch _____
 Elev. _____
 Vert. Datum: NGVD29 NADV88
 Meas. Units: Metric Imperial

Corner - Left as found Found and tagged Established Reestablished Rebuilt

Identification and type of corner found: Evidence used to identify or procedure used to establish or reestablish the corner:

CENTER LINE MONUMENTS IN STAGECOACH DRIVE
AS PER MAP, M&P VOLUME 21, PAGE 2 (STOCKTON TRIANGLE
INDUSTRIAL PARK UNIT No. 1)


A description of the physical condition of the monument as found and as set or reset:

CENTERLINE
MONUMENTS ARE 3/4 INCH IRON PIN ENCLOSED IN
CAST IRON MONUMENT BOXES, TAGGED R.C.E. 9890

SURVEYOR'S STATEMENT

This Corner Record was prepared by me or under my direction in conformance with the Land Surveyor's Act on 15 JULY, 2005.


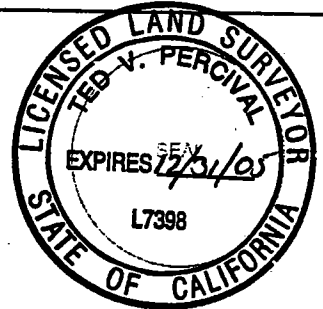

COUNTY SURVEYOR'S STATEMENT

This Corner Record was received JULY 29, 2005 and examined and filed AUGUST 1, 2005.

Signed Jeff D. Lund ~~Richard~~ LS 4440

Title Assistant County Surveyor

County Surveyor's Comment _____



(D.D. SHEET NO. 35)

FARMINGTON ROAD

ROAD

AT and SF RR

NORTH

#1
#2

#3
#4

#5 WITNESS CROSS

STAGECOACH RD

#6 STATION OR CONCRETE NAIL

#7
RD

LEGEND

- ⊥ - CUT CROW'S FOOT ON TOP OF CONCRETE CURB
- - MONUMENT (FOUND)

MONUMENT TIES

MON #1
 ① = 29⁸⁸ ft
 ② = 33⁰³ ft

MON #2
 ① = 22²⁸ ft
 ② = 25⁶⁴ ft

MON #3
 ① = 22⁴³ ft
 ② = 25⁴⁸ ft

MON #4
 ① = 22¹⁹ ft
 ② = 25⁹⁹ ft

MON #5
 ① = 22²⁶ ft
 ② = 28¹⁴ ft

MON #6
 ① = 22¹⁶ ft
 ② = 40⁰⁴ ft

MONUMENT DISTANCES

MON 1-2 = 70⁰⁴ ft
 MON 2-3 = 231²⁶ ft
 MON 3-4 = 149⁹⁸ ft
 MON 4-5 = 257⁰⁰ ft
 MON 5-6 = 392⁷² ft
 MON 6-7 = 506⁷³ ft

PETERSEN RD