


# CORNER RECORD

Document Number 05-24

City of Stockton

County of San Joaquin, California

Brief Legal Description Section 11 of C.M. Weber Grant

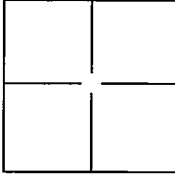

### CORNER TYPE

Government Corner  Control   
Meander  Property   
Rancho  Other

Date of Survey June 17, 2005

### COORDINATES(Optional)

N. \_\_\_\_\_

E. \_\_\_\_\_

Zone \_\_\_\_\_ NAD27  NAD83

NAD83 Epoch \_\_\_\_\_

Elev. \_\_\_\_\_

Vert. Datum: NGVD29  NADV88

Meas. Units: Metric  Imperial

Corner - Left as found  Found and tagged  Established  Reestablished  Rebuilt

Identification and type of corner found: Evidence used to identify or procedure used to establish or reestablish the corner:

Found 5/8" rebar and yellow plastic cap marked "RCE 14269" in a monument well at the approximate center line

-center line intersection of Wait Ave. and Odell Ave. as shown on Parcel Map filed in Book 20 of Parcel Maps,

at Page 93, San Joaquin County Records.

A description of the physical condition of the monument as found and as set or reset: Found 5/8" rebar and yellow plastic cap marked "RCE 14269" in a monument well.

### SURVEYOR'S STATEMENT

This Corner Record was prepared by me or under my direction in conformance with

the Land Surveyor's Act on July 29, 2005.

Signed Michael R. Conrad R.C.E. No.: 32921



### COUNTY SURVEYOR'S STATEMENT

This Corner Record was received AUGUST 1, 2005 and examined

and filed AUGUST 2, 2005.


Signed Jeff D. Lund P.L.S. or R.C.E. No.: LS 4440

Title Assistant County Surveyor

County Surveyor's Comment \_\_\_\_\_



(D.D. SHEET NO. 34)

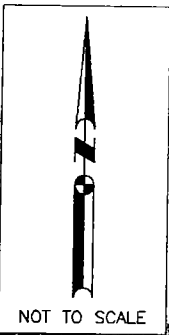

SET CHISELED "+" IN  
SIDEWALK.

ODELL AVE.

WAIT AVE.

49.97 FT.

4.76 FT.

49.97 FT

FOUND  $\frac{5}{8}$ " REBAR AND  
CAP MARKED R.C.E. 14269  
IN MONUMENT WELL.

ODELL AVE.

SET CHISELED "+" IN  
SIDEWALK.