


CORNER RECORD

Document Number 05-25
County of San Joaquin, California

City of Stockton
Brief Legal Description Section 11 of C.M. Weber Grant

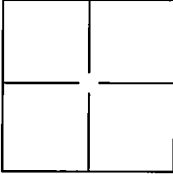

CORNER TYPE

Government Corner Control
Meander Property
Rancho Other

Date of Survey June 17, 2005

COORDINATES(Optional)

N. _____
E. _____
Zone _____ NAD27 NAD83
NAD83 Epoch _____
Elev. _____
Vert. Datum: NGVD29 NADV88
Meas. Units: Metric Imperial

Corner - Left as found Found and tagged Established Reestablished Rebuilt

Identification and type of corner found: Evidence used to identify or procedure used to establish or reestablish the corner:
Found railroad spike with no punch mark or other markings. The spike was found at the intersection of Clayton Ave. and Odell Ave., as shown on the Parcel Map filed in Book 20 of Parcel Maps, at Page 93, San Joaquin County Records.

A description of the physical condition of the monument as found and as set or reset: Found railroad spike with no punch mark or other markings.

SURVEYOR'S STATEMENT

This Corner Record was prepared by me or under my direction in conformance with the Land Surveyor's Act on July 19, 2005.

Signed Michael R. Conrad R.C.E. No.: 32921



COUNTY SURVEYOR'S STATEMENT


This Corner Record was received AUGUST 1, 2005 and examined and filed AUGUST 2, 2005.

Signed Jeff D. Lund P.L.S. or P.C.E. No.: LS 4440

Title Assistant County Surveyor
County Surveyor's Comment _____



(D.D. SHEET NO. 34)

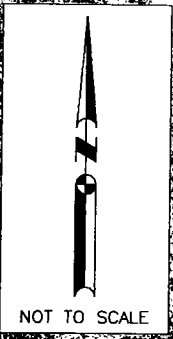

SET CHISELED "+" IN
SIDEWALK.

ODELL AVE.

FOUND RAILROAD SPIKE
WITH NO PUNCH OR
MARKINGS.

60.00 FT.

47.56 FT.

CLAYTON AVE.

CLAYTON AVE.

60.00 FT.

ODELL AVE.

SET CHISELED "+" IN
SIDEWALK.

