


# CORNER RECORD

City of Stockton Document Number 06-2  
County of San Joaquin, California  
Brief Legal Description Section 11 of C.M. Weber Grant

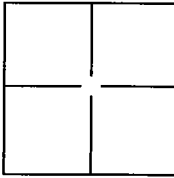

## CORNER TYPE

Government Corner ☐ Control ☐  
Meander ☐ Property ☐  
Rancho ☐ Other ☒

Date of Survey November 18, 2005

## COORDINATES(Optional)

N. \_\_\_\_\_  
E. \_\_\_\_\_  
Zone \_\_\_\_\_ NAD27 ☐ NAD83 ☐  
NAD83 Epoch \_\_\_\_\_  
Elev. \_\_\_\_\_  
Vert. Datum: NGVD29 ☐ NADV88 ☐  
Meas. Units: Metric ☐ Imperial ☐

Corner - Left as found ☐ Found and tagged ☐ Established ☐ Reestablished ☒ Rebuilt ☐

Identification and type of corner found: Evidence used to identify or procedure used to establish or reestablish the corner:  
Monument was established using swing ties from pre-construction corner record, CR-05-25.


A description of the physical condition of the monument as found and as set or reset: \_\_\_\_\_

Set 3/4" x 36" aluminum rod with 2 1/2" aluminum cap stamped RCE 32192 with a punch mark in monument well.

## SURVEYOR'S STATEMENT

This Corner Record was prepared by me or under my direction in conformance with  
the Land Surveyor's Act on January 11, 2006.

Signed [Signature] P.L.S. or R.C.E. No.: RCE 32192

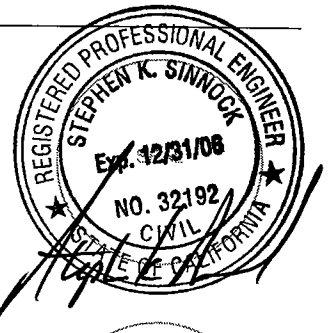

## COUNTY SURVEYOR'S STATEMENT

This Corner Record was received JANUARY 11, 2006 and examined  
and filed JANUARY 12, 2006.

Signed [Signature] P.L.S. or R.C.E. No.: 4440

Title Assistant County Surveyor

County Surveyor's Comment \_\_\_\_\_



(D.D. SHEET NO. 34)



FOUND CHISELED "+" IN  
SIDEWALK.

ODELL AVE.

SET  $\frac{3}{4}$ " X 36" ALUMINUM  
ROD WITH 2  $\frac{1}{2}$ " ALUMINUM  
CAP STAMPED RCE 32192  
WITH A PUNCH MARK IN  
MONUMENT WELL.

CLAYTON AVE.

60.00 FT.

47.56 FT.

60.00 FT.

CLAYTON AVE.

ODELL AVE.

FOUND CHISELED "+" IN  
SIDEWALK.