


CORNER RECORD

City of Stockton
Brief Legal Description Section 11 of C.M. Weber Grant

Document Number 06-3
County of San Joaquin, California

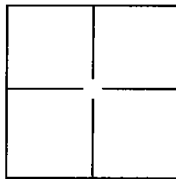

CORNER TYPE

Government Corner ☐ Control ☐
Meander ☐ Property ☐
Rancho ☐ Other ☒

Date of Survey November 18, 2005

COORDINATES(Optional)

N. _____
E. _____
Zone _____ NAD27 ☐ NAD83 ☐
NAD83 Epoch _____
Elev. _____
Vert. Datum: NGVD29 ☐ NADV88 ☐
Meas. Units: Metric ☐ Imperial ☐

Corner - Left as found ☐ Found and tagged ☐ Established ☐ Reestablished ☒ Rebuilt ☐

Identification and type of corner found: Evidence used to identify or procedure used to establish or reestablish the corner.

Monument was established using swing ties from pre-construction corner record, CR-05-26.

A description of the physical condition of the monument as found and as set or reset: _____

Set 3/4" x 36" aluminum rod with 2 1/2" aluminum cap stamped RCE 32192 with a punch mark in monument well.

SURVEYOR'S STATEMENT

This Corner Record was prepared by me or under my direction in conformance with
the Land Surveyor's Act on January 11, 2006.

Signed [Signature] P.L.S. or R.C.E. No.: RCE 32192



COUNTY SURVEYOR'S STATEMENT

This Corner Record was received JANUARY 11, 2006 and examined
and filed JANUARY 12, 2006.

Signed [Signature] P.L.S. or R.C.E. No.: 4440

Title Assistant County Surveyor
County Surveyor's Comment _____



(D.D. SHEET NO. 34)

FOUND CHISELED "+" IN
CORNER OF CONCRETE
FOOTING OF FENCE.

SET $\frac{3}{4}$ " X 36" ALUMINUM
ROD WITH 2 $\frac{1}{2}$ " ALUMINUM
CAP STAMPED RCE 32192
WITH A PUNCH MARK IN
MONUMENT WELL.

ODELL AVE.


46.19 FT.

58.22 FT.

62.46 FT.

ODELL AVE.

FOUND CHISELED "+" IN
THE TOP OF A CHAIN LINK
FENCE POST.

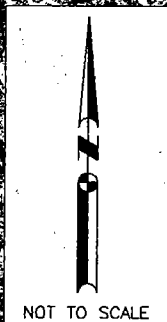

NOT TO SCALE