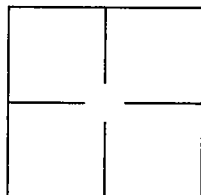


CORNER RECORD

Document Number 06 - 06City of MANTECA County of SAN JOAQUIN, CaliforniaBrief Legal Description: JOSEPH ROAD, NORTH MAIN STREET AND LOUISE AVENUE**CORNER TYPE**

Government Corner	☐	Control	☒
Meander	☐	Property	☐
Rancho	☐	Other	☐

Date of Survey FEBRUARY 28, 2005**COORDINATES (Optional)**

N _____
E _____
Zone _____ NAD27 ☐ NAD83 ☐
NAD83 Epoch _____
Elevation _____
Vert. Datum: NGVD29 ☐ NADV88 ☐
Meas Units: Metric ☐ Imperial ☐

Corner - Left as found ☒ Found and tagged ☐ Established ☐ Reestablished ☐ Rebuilt ☐

Identification and type of corner found: Evidence used to identify or procedure used to establish or reestablish the corner:

SEE SKETCH ON OTHER SIDE


A description of the physical condition of the monument as found and as set or reset:

SEE SKETCH ON OTHER SIDE**SURVEYOR'S STATEMENT**

This Corner Record was prepared by me or under my direction in conformance with

the Land Surveyors' Act on MARCH 21, 2005.

Signed

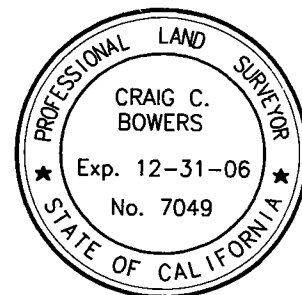P.L.S. Number 7049**COUNTY SURVEYOR'S STATEMENT**This Corner Record was received MARCH 14, 2006 and examinedand filed APRIL 13, 2006.

Signed

P.L.S. or R.C.E. Number 4440Title ASSISTANT COUNTY SURVEYOR

County Surveyor's Comment _____

