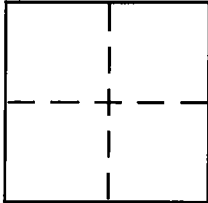


CORNER RECORD

Document Number 06-07City of TRACYCounty of SAN JOAQUIN, CaliforniaBrief Legal Description CITY OF TRACY STREET MONUMENT 119.22' NW OF THE INTERSECTION OF VALERIE LANE AND LINCOLN BLVD.

CORNER TYPE

Government Corner ☐ Control ☐
Meander ☐ Property ☐
Rancho ☐ Other ☒
Date of Survey DECEMBER 11, 2001

COORDINATES (Optional)

N. _____
E. _____
Zone _____ NAD27 ☐ NAD83 ☐
NAD83 Epoch _____
Elev. _____
Vert. Datum: NGVD29 ☐ NAVD88 ☐
Meas. Units: Metric ☐ Imperial ☐

Corner - Left as found ☐ Found and tagged ☐ Established ☐ Reestablished ☒ Rebuilt ☐

Identification and type of corner found: Evidence used to identify or procedure used to establish or reestablish the corner:

FOUND STREET MONUMENT AT THE INTERSECTION OF VALERIE LANE AND LINCOLN BLVD., AT THE INTERSECTION OF BONDY LANE AND LINCOLN BLVD., AND AT A POINT OF CURVE 82.81' SW OF THE INTERSECTION OF BONDY LANE AND LINCOLN BLVD., PER TRACT NO. 964, ARNOLD PARK UNIT NO. 6, 19 M & P 97, S.J.C.R.

A description of the physical condition of the monument as found and as set or reset:

ORIGINAL STREET MONUMENT DESTROYED PER CONSTRUCTION, SET STANDARD CITY MONUMENT IN MONUMENT WELL, 2-1/2" BRASS DISC STAMPED L.S. 5412.

SURVEYOR'S STATEMENT

This Corner Record was prepared by me or under my direction in conformance with the Land Surveyor's Act on MAY 8th 2006

Signed _____ P.L.S. or R.C.E. No. 5412




COUNTY SURVEYOR'S STATEMENT

This Corner Record was received MAY 11, 2006

and examined and filed MAY 16, 2006

Signed Jeff D. Lund P.L.S. or R.C.E. No. 4440

Title ASSISTANT COUNTY SURVEYOR

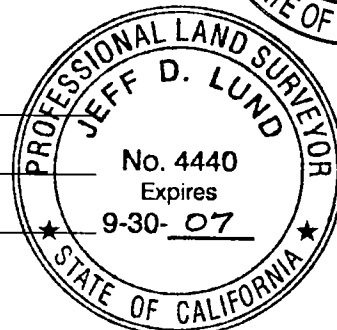

County Surveyor's Comment THIS CORNER RECORD IS NOT IN COMPLIANCE WITH SECTION 8773.2 (b) OF THE PLS ACT REGARDING RESUBMITTAL WITHIN 60 DAYS.

