


CORNER RECORD

Document Number 06-15

City of LODI

County of SAN JOAQUIN, California

Brief Legal Description WEST 1/4 CORNER OF SECTION 5 OF T3N, R7E OF THE MDB 1M

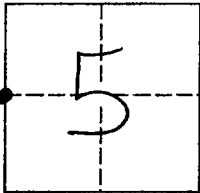

CORNER TYPE

Government Corner ☒ Control ☐
 Meander ☐ Property ☐
 Rancho ☐ Other ☐

Date of Survey Oct. 25, 2005

COORDINATES(Optional)

N. _____
 E. _____
 Zone _____ NAD27 ☐ NAD83 ☐
 NAD83 Epoch _____
 Elevation _____
 Vert. Datum: NGVD29 ☐ NAV88 ☐
 Meas. Units: Metric ☐ Imperial ☒

Corner - Left as found ☒ Found and tagged ☐ Established ☐ Reestablished ☐ Rebuilt ☐

Identification and type of corner found: Evidence used to identify or procedure used to establish or reestablish the corner:

FOUND 3/4" IRON ROD WITH NO TAG IN MONUMENT WELL.
MONUMENT IS 0.55' BELOW THE A.C. SURFACE.

A description of the physical condition of the monument as found and as set or reset:

MONUMENT WAS FOUND IN GOOD CONDITION.

SURVEYOR'S STATEMENT

This Corner Record was prepared by me or under my direction in conformance with

the Land Surveyor's Act on MAY 25, 2006.

Signed [Signature] P.L.S. or R.C.E. Number 8022

For the State of California
 Department of Transportation

COUNTY SURVEYOR'S STATEMENT


This Corner Record was received MAY 30, 2006 and examined

and filed JUNE 9, 2006.


Signed [Signature] P.L.S. or R.C.E. Number 4440

Title ASSISTANT COUNTY SURVEYOR

County Surveyor's Comment _____

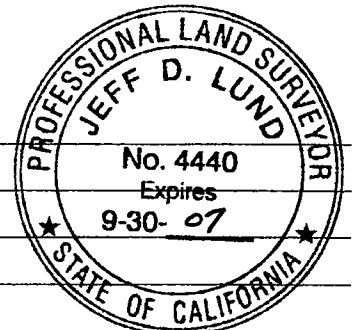

(D.D. SHEET NO. 16)

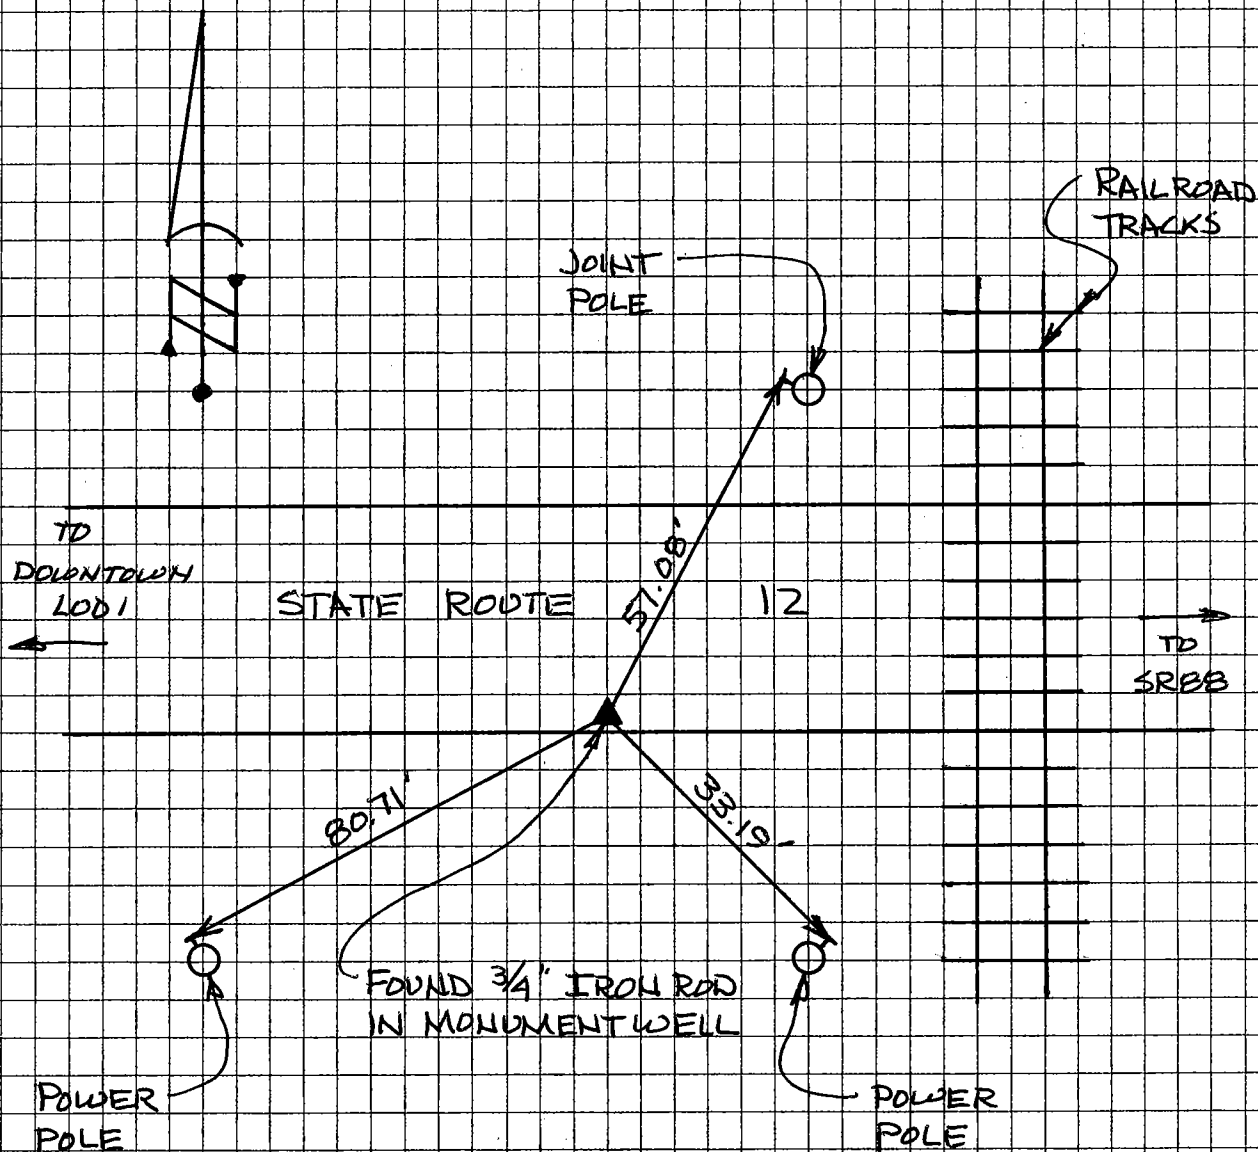

NOTE: ALL REFERENCE POINTS
ARE PK NAILS WITH
BRASS WASHER STAMPED
"CALTRANS" IN POLE.

THE TIES SHOWN HEREON ARE FOR THE PURPOSE OF
PERPETUATING THE MONUMENTATION CURRENTLY EXISTING.
NO ATTEMPT WAS MADE TO DETERMINE THE VALIDITY
OF THE MONUMENT OR ITS PROPER LOCATION IN
RELATION TO LEGAL BOUNDARY LINES IN THE AREA.