

CORNER RECORD

Document Number 06-16


City of

County of SAN JOAQUIN, California

Brief Legal Description 707.31' SOUTHWEST OF FAIRCHILD LANE ALONG CENTERLINE OF STATE ROUTE 88 IN SECTION 12 OF THE C.M. WEBER GRANT

CORNER TYPE

COORDINATES(Optional)

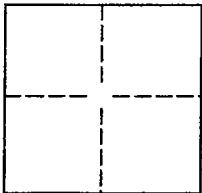

Government Corner ☐ Control ☐
Meander ☐ Property ☐
Rancho ☐ Other ☒

Date of Survey 10/24/05

N.
E.
Zone NAD27 ☐ NAD83 ☐
NAD83 Epoch
Elevation
Vert. Datum: NGVD29 ☐ NAV88 ☐
Meas. Units: Metric ☐ Imperial ☒

Corner - Left as found ☒ Found and tagged ☐ Established ☐ Reestablished ☐ Rebuilt ☐

Identification and type of corner found: Evidence used to identify or procedure used to establish or reestablish the corner:

FOUND BOLT HEAD IN A.C. PAVEMENT IN MONUMENT WELL
MONUMENT IS DOWN 1.1 FT BELOW THE NEW A.C. SURFACE.

A description of the physical condition of the monument as found and as set or reset:

MONUMENT FOUND IN GOOD CONDITION

SURVEYOR'S STATEMENT

This Corner Record was prepared by me or under my direction in conformance with the Land Surveyor's Act on MAY 25, 2006.

Signed [Signature] P.L.S. or R.C.E. Number 8022
For the State of California
Department of Transportation




COUNTY SURVEYOR'S STATEMENT

This Corner Record was received MAY 30, 2006 and examined and filed JUNE 9, 2006.

Signed [Signature] P.L.S. or R.C.E. Number 4440
Title ASSISTANT COUNTY SURVEYOR
County Surveyor's Comment



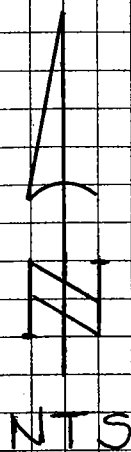

FOUND $\frac{1}{4}$ " x $\frac{1}{4}$ "
SQUARE ROD IN
MONUMENT WELL

TO
LOCKEFORD

FAIRCHILD
LANE

JOINT POLE

707.31'
STATE ROUTE 88

37.18' GUY POLE

FOUND BOLT HEAD IN
PAVEMENT IN MONUMENT
WELL DOWN 1.1' BELOW
FINISH A.C. SURFACE

40.61' TELEPHONE POLE

134.93'

JOINT POLE

(WATERLOO
ROAD)

TO
STOCKTON

NOTE: ALL REFERENCE POINTS ARE
PK NAILS W/CALTRANS
BRASS WASHERS IN POLES,

THE TIES SHOWN HEREON ARE FOR THE PURPOSE OF
PERPETUATING THE MONUMENTATION CURRENTLY
EXISTING. NO ATTEMPT WAS MADE TO
DETERMINE THE VALIDITY OF THE MONUMENTS
OR THEIR PROPER LOCATION IN RELATION TO
LEGAL BOUNDARY LINES IN THE AREA.