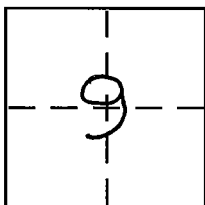


CORNER RECORD

Document Number 06-22City of UNINCORPORATEDCounty of SAN JOAQUIN, CaliforniaBrief Legal Description 14 R.S. 147T.2S
R.9E

CORNER TYPE

Government Corner ☐ Control ☐
Meander ☐ Property ☒
Rancho ☐ Other ☐
Date of Survey MAY 23, 2006

COORDINATES (Optional)

N. _____
E. _____
Zone _____ NAD27 ☐ NAD83 ☐
NAD83 Epoch _____
Elev. _____
Vert. Datum: NGVD29 ☐ NAVD88 ☐
Meas. Units: Metric ☐ Imperial ☐

Corner - Left as found ☐ Found and tagged ☐ Established ☐ Reestablished ☒ Rebuilt ☐

Identification and type of corner found: Evidence used to identify or procedure used to establish or reestablish the corner:


SEE SKETCH ON BACK.

A description of the physical condition of the monument as found and as set or reset:

SEE SKETCH ON BACK.

SURVEYOR'S STATEMENT

This Corner Record was prepared by me or under my direction in conformance with
the Land Surveyor's Act on MAY 25, 2006.

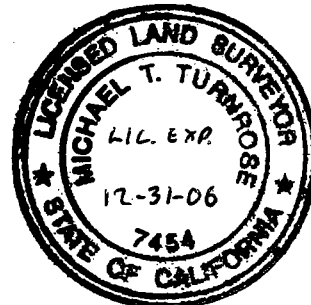Signed Michael T. Turnor P.L.S. or R.C.E. No. 7454

COUNTY SURVEYOR'S STATEMENT

This Corner Record was received MAY 30, 2006and examined and filed JUNE 12, 2006Signed Jeff D. Lund P.L.S. or R.C.E. No. 4440Title Assistant County Surveyor

County Surveyor's Comment _____




LEGEND & NOTES:

- INDICATES SET 30" LONG 3/4" IRON PIPE WITH PLUG "TURNROSE L.S. 7454"
- INDICATES FOUND OLD 1/2" IRON PIPE AS PER (A)
- ▲ INDICATES FOUND NEWER 1/2" IRON PIPE--NO MAP OF RECORD
- (A) INDICATES DATA TAKEN FROM 14 R.S. 147
- (M) INDICATES MEASURED AS PER THIS SURVEY
- N.T.S. INDICATES NOT TO SCALE

ALL DISTANCES SHOWN ARE IN FEET AND DECIMALS THEREOF.

8 R.S. 193

McHENRY AVE.

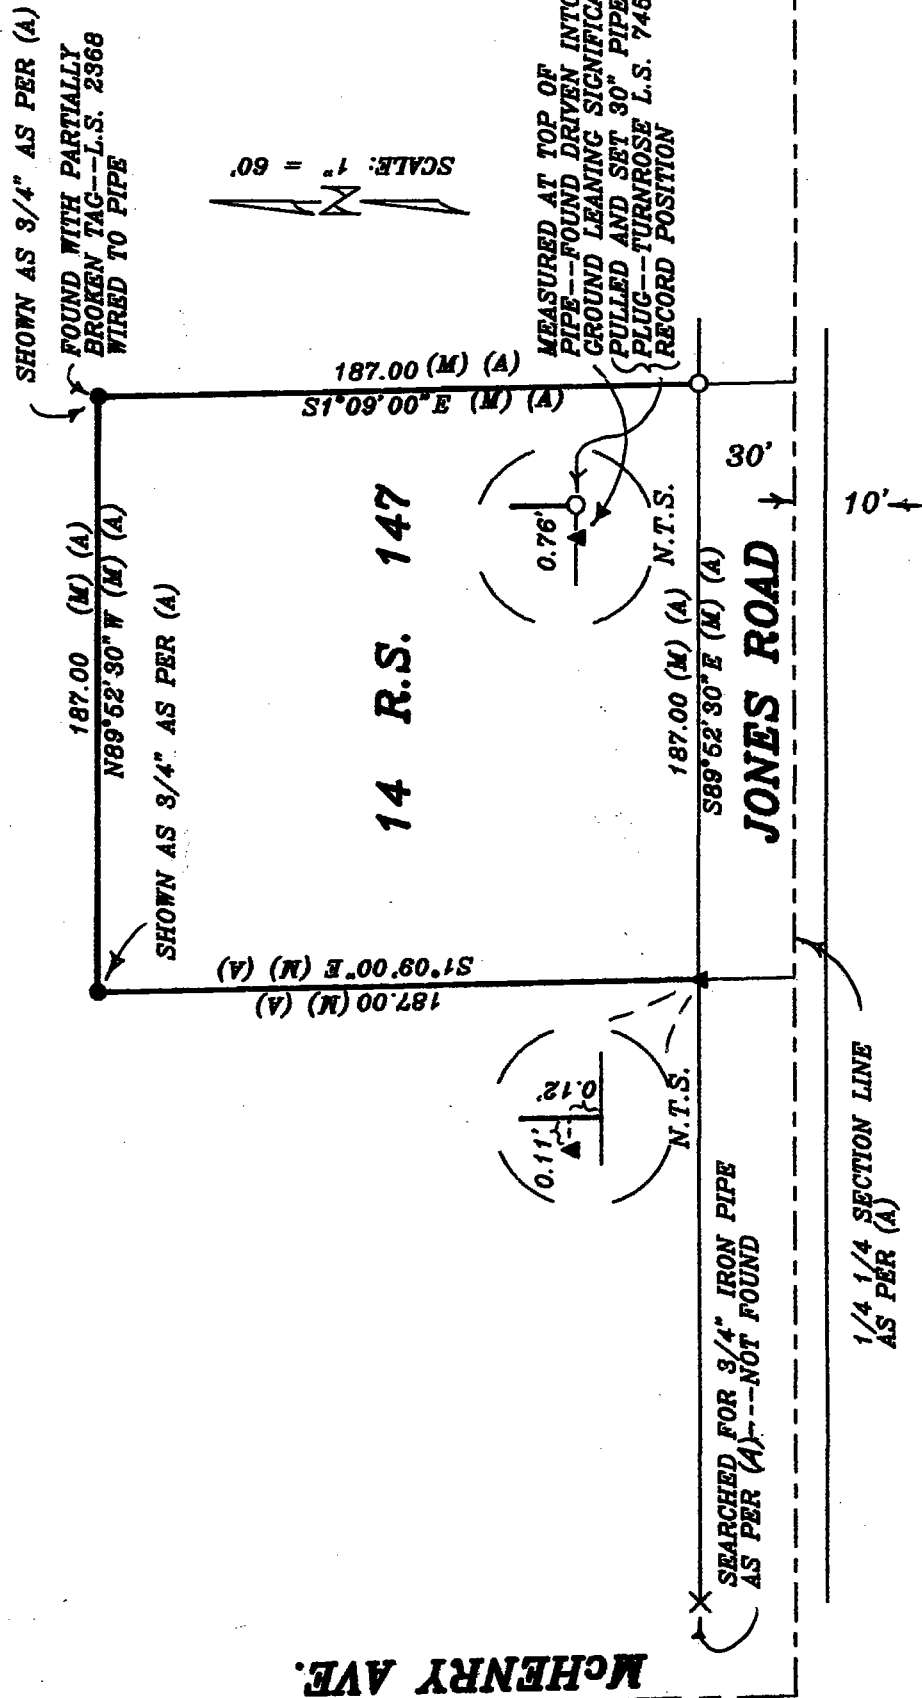

Job # 06-16