


CORNER RECORD

City of TRACY

Document Number 06-26

County of SAN JOAQUIN, California

Brief Legal Description SITUATE IN THE SOUTHEAST QUARTER OF SECTION 19, T.2 S., R. 5 E., M.B.D.&M.

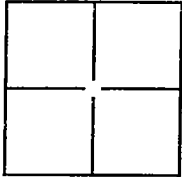

CORNER TYPE

Government Corner ☐ Control ☐
Meander ☐ Property ☐
Rancho ☐ Other ☒

Date of Survey SEP. 8, 2006

COORDINATES (Optional)

N _____
E _____
Zone _____ NAD27 ☐ NAD83 ☐
NAD83 Epoch _____
Elevation _____
Vert. Datum: NVGD29 ☐ NVGD88 ☐
Meas Units: Metric ☐ Imperial ☐

Corner— Left as found ☐ Found and tagged ☐ Established ☐ Reestablished ☒ Rebuilt ☐

Identification and type of corner found: Evidence used to identify or procedure used to establish or reestablish the corner.
SCRIBED "+" MARKING A 5.5 FOOT WITNESS TO THE S.E. CORNER OF LOT 8 PER 40-M&P. 61, S.J.C.R. WAS DESTROYED BY CONSTRUCTION. REESTABLISHED CORNER LOCATION PER TIES SET ON FIELD SURVEY DATED AUG. 24, 2006 AND SHOWN ON THE DIAGRAM DRAWN ON PAGE 2 OF 2 HEREON.


A description of the physical condition of the monument as found and as set or reset:

SET CUT "+" IN CONCRETE SIDEWALK WITH NAIL AND BRASS TAG STAMPED LS 6805.

SURVEYOR'S STATEMENT

This Corner Record was prepared by me or under my direction in conformance with the Land Surveyor's Act on SEPTEMBER 18, 2006.

Signed _____ P.L.S. or R.C.E. Number LS 6805

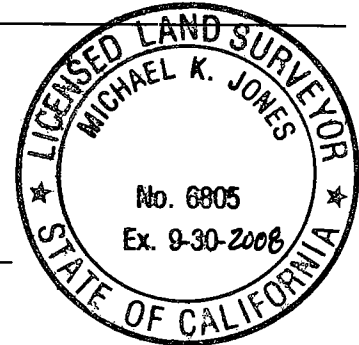

COUNTY SURVEYOR'S STATEMENT

This Corner Record was received SEPTEMBER 29, 2006 and examined and filed OCTOBER 4, 2006.

Signed Jeff D. Lund P.L.S. or R.C.E. Number 4440

Title ASSISTANT COUNTY SURVEYOR

County Surveyor's Comment _____



