


CORNER RECORD

City of STOCKTON Document Number 06-29
County of San Joaquin, California

Brief Legal Description LOT 59 OF "MASSWOOD PARK" MAP 8-52 S.J.C.R.

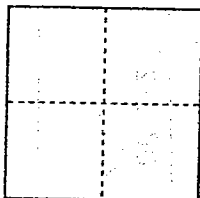

CORNER TYPE

Government Corner ☐ Control ☐
Meander ☐ Property ☒
Rancho ☐ Other ☐

Date of Survey AUGUST 7
2006

COORDINATES (Optional)

N. _____
E. _____
Zone _____ NAD27 ☐ NAD83 ☐
NAD83 Epoch _____
Elev. _____
Vert. Datum: NGVD29 ☐ NAVD88 ☐
Meas. Units: Metric ☐ Imperial ☐

Corner - Left as found ☐ Found and tagged ☐ Established ☒ Reestablished ☐ Rebuilt ☐

Identification and type of corner found: Evidence used to identify or procedure used to establish or reestablish the corner:

SEE PLAT ON BACK


A description of the physical condition of the monument as found and as set or reset:

SET 3/4" DIA, 30" LONG REBAR TAGGED "CS 8080"

SURVEYOR'S STATEMENT

This Corner Record was prepared by me or under my direction in conformance with the Land Surveyors' Act on NOVEMBER 2ND, 2006.

Signed _____ L.S. or R.C.E. Number 8080

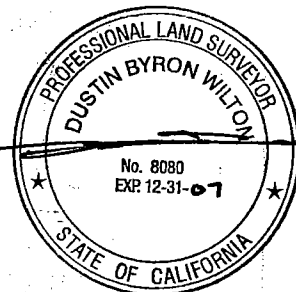


COUNTY SURVEYOR'S STATEMENT

This Corner Record was received NOVEMBER 7, 2006 and examined and filed NOVEMBER 14, 2006.


Signed Jeff D. Lund P.L.S. No. 4440

Title Assistant County Surveyor

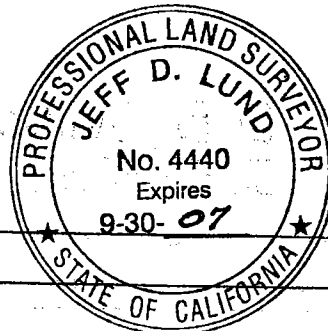

County Surveyor's Comment _____

(D.D. Sheet No. 34)

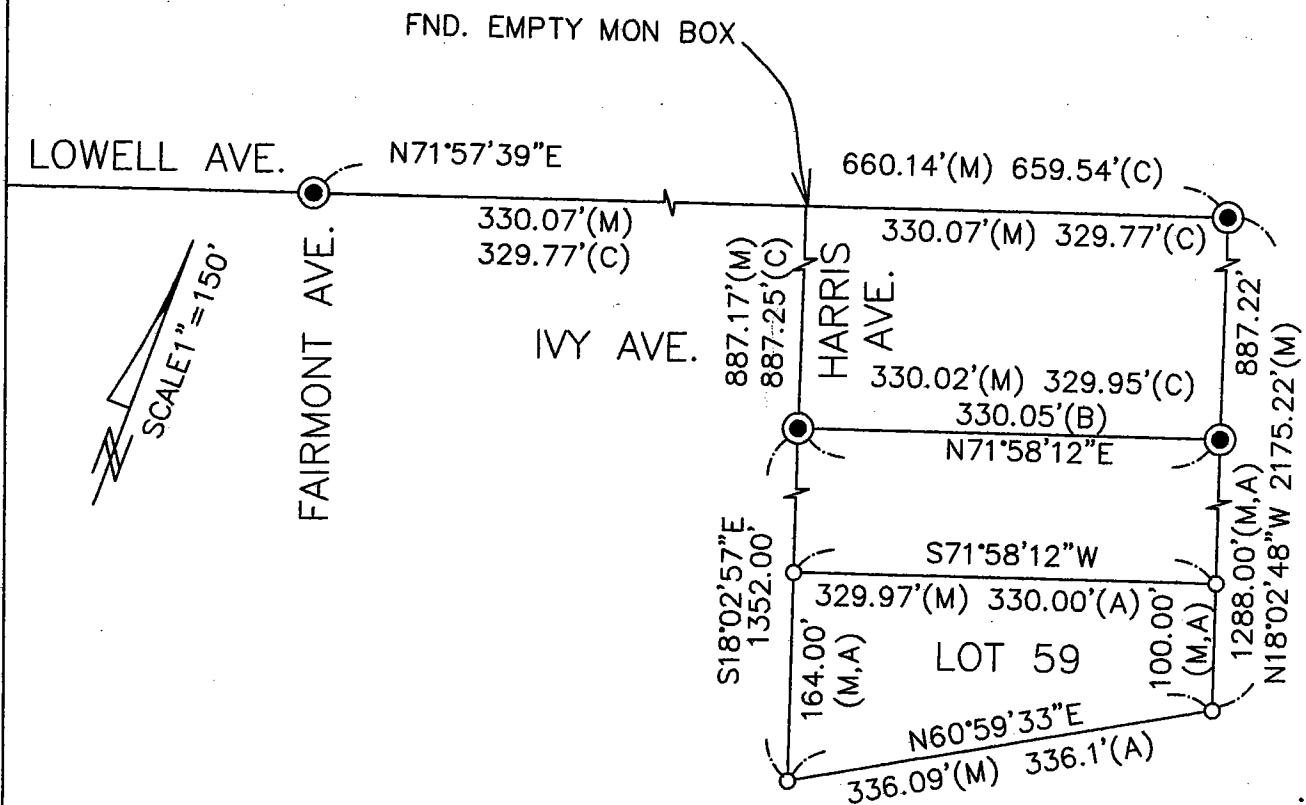

REFERENCES:

- (A) M.&P. 8-52, S.J.C.R.
- (B) R.S.33-111, S.J.C.R.
- (C) FIELD BOOK #492, S.J.C.S.R.

LEGEND

- FD. 1" IRON PIN IN MON BOX-NO TAG - NO RECORD
- SET 3/4" X 30" LONG REBAR TAGGED LS 8080
- FD. AS DESCRIBED

SFN SEARCHED-FOUND NOTHING
+ CALCULATED POINT-NOT SET

S.J.C.R. SAN JOAQUIN COUNTY RECORDS
S.J.C.S.R. SAN JOAQUIN COUNTY SURVEYOR'S RECORDS

D.B. Wilton

LAND SURVEYING

PO BOX 435 LODI CA 95241-0435
(209) 747-0169 dbwsurvey@yahoo.com