


CORNER RECORD

City of STOCKTON

Document Number 07-03
County of San Joaquin, California

Brief Legal Description LOT 2 OF BLOCK B OF SUNSET AS SHOWN
ON MAP 6-19 S.J.C.R., BEING A PORTION OF SEC. 22, C.M. WEBER GRANT

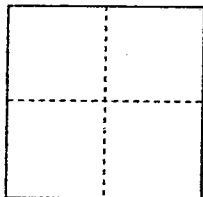

CORNER TYPE

Government Corner ☐ Control ☐
Meander ☐ Property ☒
Rancho ☐ Other ☐

Date of Survey DECEMBER 8th
2006

COORDINATES (Optional)

N. _____
E. _____
Zone _____ NAD27 ☐ NAD83 ☐
NAD83 Epoch _____
Elev. _____
Vert. Datum: NGVD29 ☐ NAVD88 ☐
Meas. Units: Metric ☐ Imperial ☐

Corner - Left as found ☐ Found and tagged ☐ Established ☒ Reestablished ☐ Rebuilt ☐

Identification and type of corner found: Evidence used to identify or procedure used to establish or reestablish the corner:

SEE PLAT ON BACK

A description of the physical condition of the monument as found and as set or reset: SET 3/4" - 30"
ONLY REBAR TAGGED "LS 8080"

SURVEYOR'S STATEMENT

This Corner Record was prepared by me or under my direction in conformance with the Land Surveyors' Act on DECEMBER 10th, 2006.

Signed _____ L.S. or R.C.E. Number 8080




COUNTY SURVEYOR'S STATEMENT

This Corner Record was received JANUARY 18, 2007 and examined and filed JANUARY 19, 2007.

Signed Jeff D. Lund P.L.S. No. 4440

Title Assistant County Surveyor

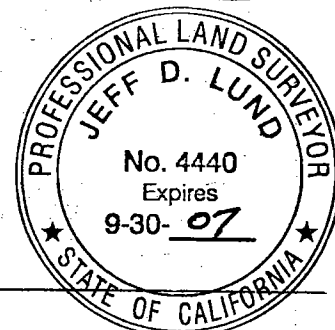

County Surveyor's Comment _____

(D.D. Sheet No. 31 D)

