

CORNER RECORD

Document Number 07-24City of -County of SAN JOAQUIN, CaliforniaBrief Legal Description W 1/4 CORNER, SECTION 11, T2S RTE MDB 1M

CORNER TYPE

Government Corner ☒ Control ☐
 Meander ☐ Property ☐
 Rancho ☐ Other ☐

Date of Survey 4/26/07

COORDINATES(Optional)

N. _____
 E. _____
 Zone _____ NAD27 ☐ NAD83 ☐
 NAD83 Epoch _____
 Elevation _____
 Vert. Datum: NGVD29 ☐ NAV88 ☐
 Meas. Units: Metric ☒ Imperial ☐

Corner - Left as found ☐ Found and tagged ☐ Established ☐ Reestablished ☒ Rebuilt ☐

Identification and type of corner found: Evidence used to identify or procedure used to establish or reestablish the corner:

RESET MONUMENT USING THE TWO FOUND REFERENCE POINTS. MEASURED THE
DISTANCE BETWEEN THE POINTS AND PRORATED THE DISTANCES BETWEEN THE
POINTS AND THE MONUMENT. SET A 3 1/2" DIA. BRASS DISK STAMPED AS SHOWN
ON BACK IN A 2" ID IRON PIPE SET IN CONCRETE, FLUSH WITH THE PAVED ROADWAY.
SET PK NAILS FOR 2' SWING TIES. SET TWO ADDITIONAL REFERENCE POINTS.


A description of the physical condition of the monument as found and as set or reset:

MONUMENT WAS SET IN GOOD CONDITION.

SURVEYOR'S STATEMENT

This Corner Record was prepared by me or under my direction in conformance with
 the Land Surveyor's Act on 5/21, 2007.

Signed [Signature] P.L.S. or R.G.E. Number 8022
 For the State of California
 Department of Transportation

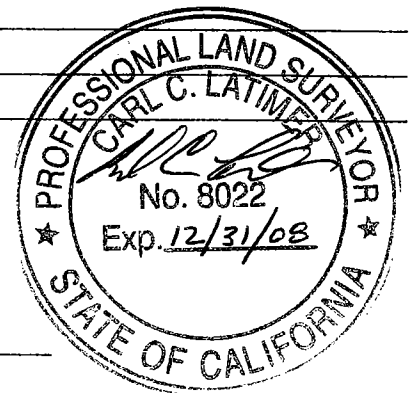


COUNTY SURVEYOR'S STATEMENT

This Corner Record was received JULY 2, 2007 and examined
 and filed JULY 9, 2007.


Signed [Signature] P.L.S. or R.G.E. Number 4440

Title Assistant County Surveyor

County Surveyor's Comment _____

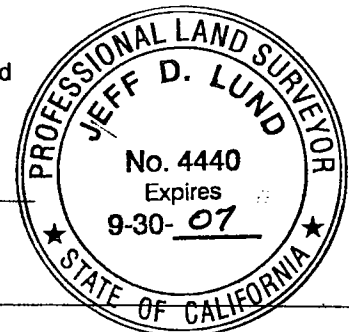

FOUND 2" DIA
BRASS DISK IN
MONUMENT WELL
AT SECTION CORNER
(CR 97-42)

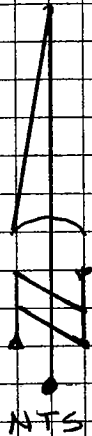

FOUND PK NAIL
W/CALTRANS
WASHER (CR 97-42)

ONRAMP

OFFRAMP

FOUND PK NAIL
W/CALTRANS
WASHER IN BRIDGE
DECK EXPANSION
JOINT (CR 97-42)

STATE ROUTE

99

NOTES

- 1) ALL DISTANCES ARE GROUND.
- 2) GRID DISTANCES ON OLD CORNER RECORD (97-42) WERE DIVIDED BY 0.99993159 TO OBTAIN GROUND DISTANCES.
- 3) ALL MEASURED DISTANCES ARE MARKED (M)
- 4) ALL RECORDED DISTANCES ARE MARKED (R)
- 5) ALL DISTANCES ARE IN METERS.

429.549 (M)

429.554 (R)

469.004 (M)


375.481 (R)

375.486 (M)

469.005 (R)

93.518 (R)

93.518 (M)

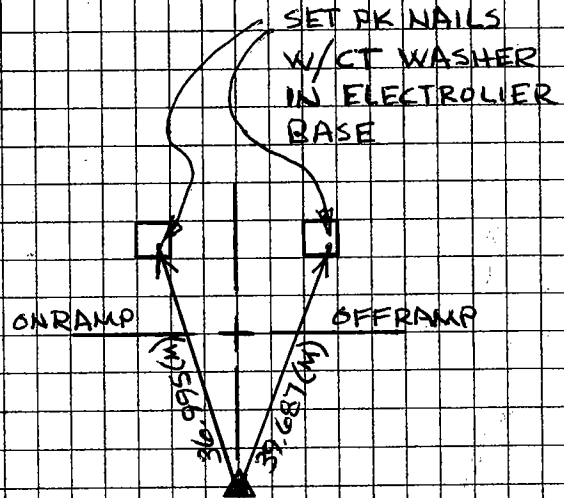

ADDITIONAL TIES

SET 3 1/2" BRASS DISK STAMPED AS SHOWN IN 2" ID IRON PIPE IN CONCRETE FLUSH W/AL ROADWAY

