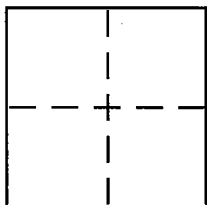


CORNER RECORD

Document Number 07-26

City of _____

County of SAN JOAQUIN, CaliforniaBrief Legal Description EAST PARCEL SHOWN ON 14 R.S. 126

CORNER TYPE

Government Corner ☐ Control ☐
Meander ☐ Property ☒
Rancho ☐ Other ☐
Date of Survey 5/17 & 5/21/07

COORDINATES (Optional)

N. _____
E. _____
Zone _____ NAD27 ☐ NAD83 ☐
NAD83 Epoch _____
Elev. _____
Vert. Datum: NGVD29 ☐ NAVD88 ☐
Meas. Units: Metric ☐ Imperial ☐

Corner - Left as found ☒ Found and tagged ☐ Established ☐ Reestablished ☒ Rebuilt ☒

Identification and type of corner found: Evidence used to identify or procedure used to establish or reestablish the corner:


SEE SKETCH ON BACK.

A description of the physical condition of the monument as found and as set or reset: _____

SEE SKETCH ON BACK.

SURVEYOR'S STATEMENT

This Corner Record was prepared by me or under my direction in conformance with
the Land Surveyor's Act on JULY 3, 2007

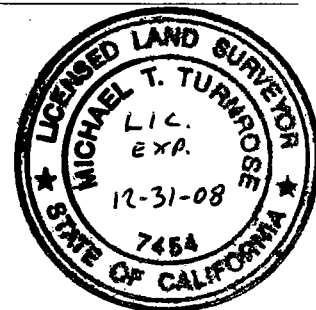
Signed Michael T. Turnrose (P.L.S. or R.C.E. No. 7454)

COUNTY SURVEYOR'S STATEMENT

This Corner Record was received JULY 6, 2007
and examined and filed JULY 12, 2007


Signed Jeff D. Lund P.L.S. or R.C.E. No. 4440Title Assistant County Surveyor

County Surveyor's Comment _____

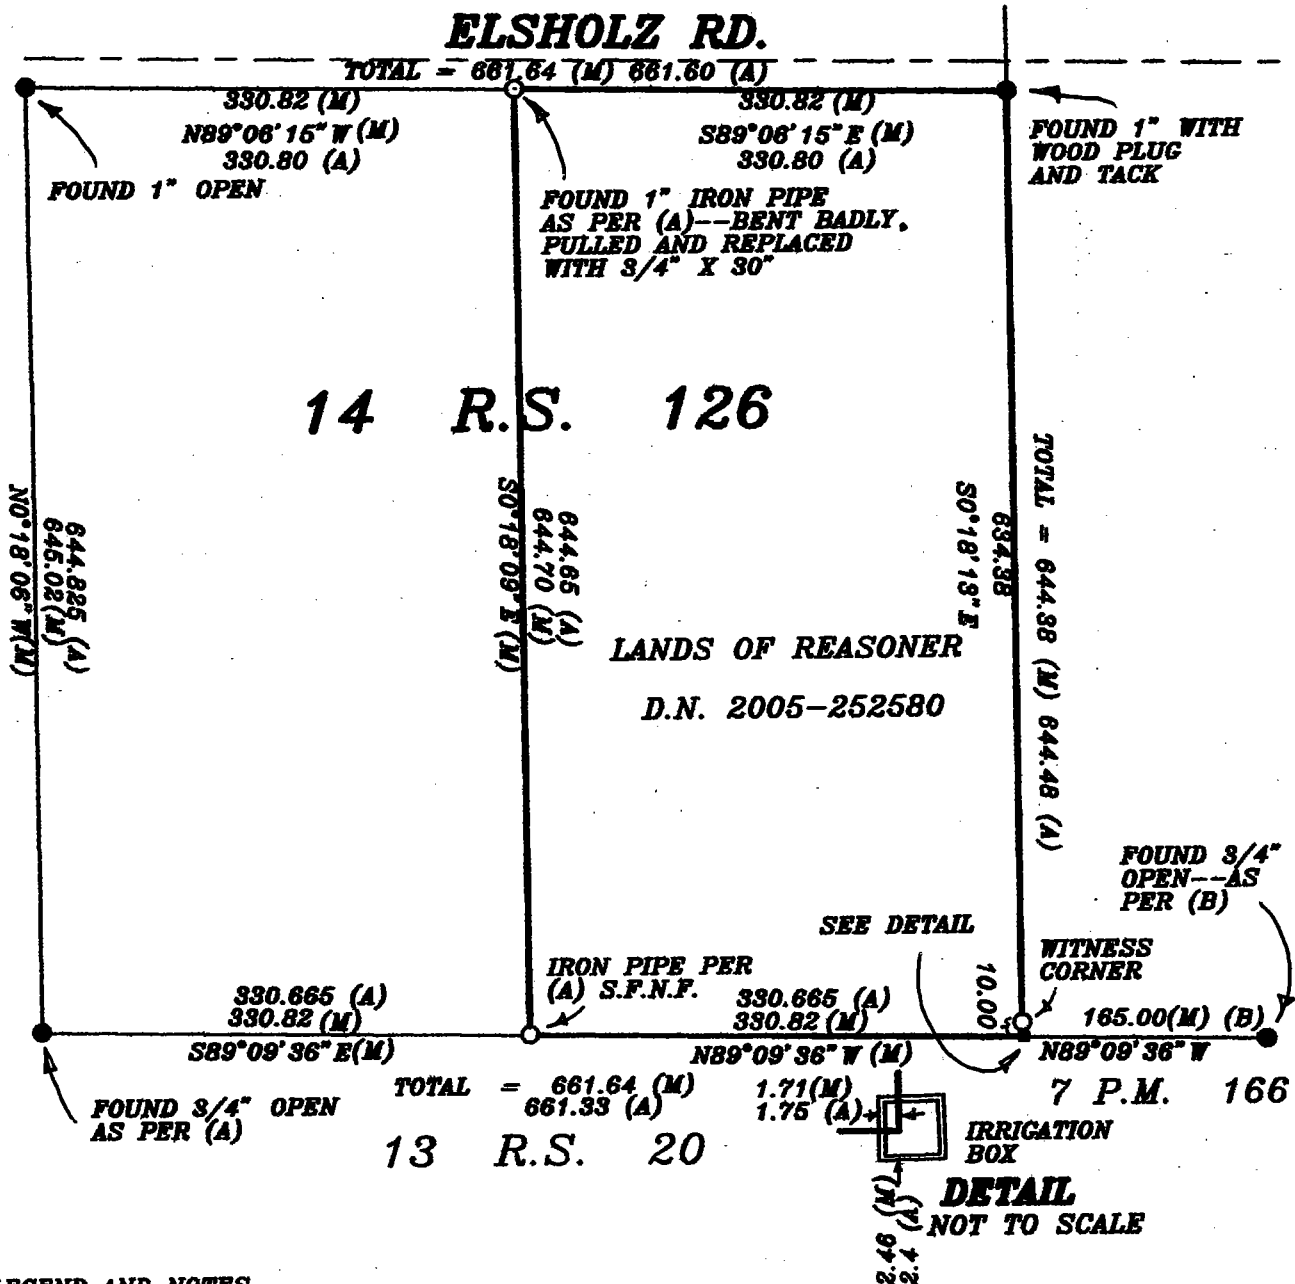

LEGEND AND NOTES

- INDICATES SET 3/4" X 30" IRON PIPE WITH PLUG---L.S. 7454 TURNROSE
- INDICATES FOUND IRON PIPE AS NOTED---ACCEPTED AS PER 14 R.S. 126---UNLESS NOTED OTHERWISE
- (M) INDICATES MEASURED AS PER THIS SURVEY
- R.S. RECORD OF SURVEY
- P.M. PARCEL MAP
- S.F.N.F. SEARCHED FOR NOT FOUND
- DISTANCES SHOWN ARE IN FEET OR DECIMALS THEREOF
- REFERENCES:
- (A) RECORD OF SURVEY, 14 R.S. 126
- (B) PARCEL MAP, 7 P.M. 166

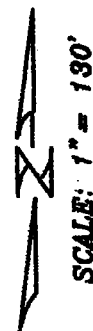

07-15