

# CORNER RECORD

Document Number 07-27

City of \_\_\_\_\_

County of San Joaquin, CaliforniaBrief Legal Description Lots 5 and 6 of Fractional block 15 of "Map of Lockeford"  
as shown on M. & P. 1-70 S.J.C.R.**CORNER TYPE**

|                   |                          |          |                                     |
|-------------------|--------------------------|----------|-------------------------------------|
| Government Corner | <input type="checkbox"/> | Control  | <input type="checkbox"/>            |
| Meander           | <input type="checkbox"/> | Property | <input checked="" type="checkbox"/> |
| Rancho            | <input type="checkbox"/> | Other    | <input type="checkbox"/>            |

Date of Survey March 28, 2007**COORDINATES(Optional)**

N. \_\_\_\_\_  
E. \_\_\_\_\_  
Zone \_\_\_\_\_ NAD27 ☐ NAD83 ☐  
NAD83 Epoch \_\_\_\_\_  
Elev. \_\_\_\_\_  
Vert. Datum: NGVD29 ☐ NADV88 ☐  
Meas. Units: Metric ☐ Imperial ☐

Corner - Left as found ☐ Found and tagged ☐ Established ☒ Reestablished ☐ Rebuilt ☐


Identification and type of corner found: Evidence used to identify or procedure used to establish or reestablish the corner.

Set outside property corners of the two lots. See plat on back.


A description of the physical condition of the monument as found and as set or reset: \_\_\_\_\_

Set 3/4" rebar 30" long, tagged "L.S. 8080"**SURVEYOR'S STATEMENT**

This Corner Record was prepared by me or under my direction in conformance with

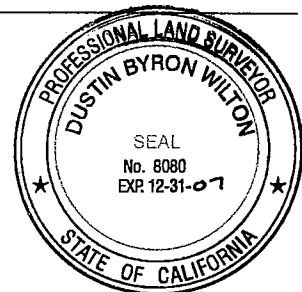the Land Surveyor's Act on March 30th, 2007.Signed [Signature] P.L.S. or R.C.E. No.: 8080**COUNTY SURVEYOR'S STATEMENT**This Corner Record was received AUGUST 6, 2007 and examinedand filed AUGUST 10, 2007.Signed [Signature] P.L.S. or R.C.E. No.: 4440Title Assistant County Surveyor

County Surveyor's Comment \_\_\_\_\_

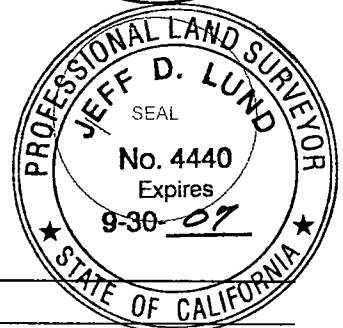

(D.D. Sheet No's. 9 &amp; 10)

