
City of		Document Number <u>CR-07-33</u>		
	TULLY ROAD, 2657' ± SOUTH OF KETTLEMAN LANE.	County of	San Joaquin,	- Californi
	CORNER TYPE			
	Government Corner 🛛 Control 🗆	N	OORDINATES (Opt	·
	Meander □ Property □ Rancho □ Other □	Zone	NAD27 och	□ NAD83 □
	Date of Survey <u>April 19, 2007</u>		n: NGVD29 🗆	NAVD88 ☐ Imperial ☒
Corner - Left as fo	ound 🛛 Found and tagged 🗌 Established 🔲	Reestabli	shed 🗍 Rebu	vilt []
dentification and type	e of corner found: Evidonco used to ideatif			
SEE SKETCH ON BACKS	e of corner found: Evidence used to identify or proce IDE.			blish the corne
A description of the ph	visical condition of the pro-			
OUND MONUMENT IN	ysical condition of the monument as found and as s GOOD CONDITION. SEE SKETCH ON BACKSIDE.	set or reset:		
	SURVEYOR'S STATEMENT		OFFCCIA	
nis Corner Record was	prepared by me or under my direction in conforma	anno with	P RUFESSION	
ne Land Surveyors' A	ct on October 18 2007.	ince with	II co I	1
gned <i>Memu</i>	R.C.E. Number_C30890		No. C30890	; / LTRS2
		<del></del>	STATE OF CALLY	REIL
	DUNTY SURVEYOR'S STATEMENT as received <i>DCTOBER</i> 19 , 2007 and exa		OF CALL	Pois
nd filed Octob		mined	11 (4) 40 (20	<b>4</b>
gned	B S. O		INI I AM	
le Assistant Count	P.L.S. No. 4440		CSIONAL ENV	
	<u> </u>			多回
ounty Surveyor's Cor	mment	l	No. 444	) शि
IS CORNER RECORD IS	NOT IN COMPLIANCE WITH SECTION 8773.2(b)		9-30- 09	· / . //
THE PLS ACT REGARDI	NG RESUBMITTAL WITHIN 60 DAYS.		To so and	
		·····	OF CAL	FORI

(D.D. Sheet No. 18 )

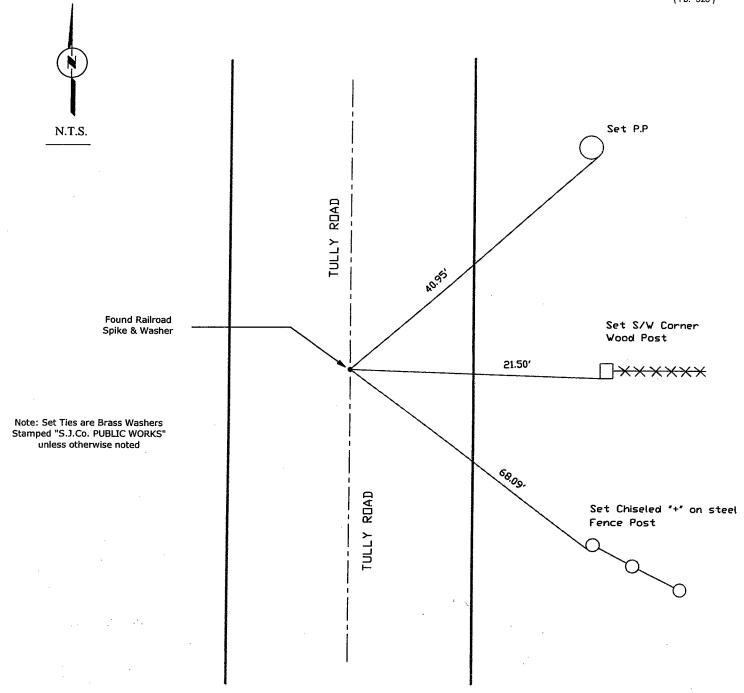

Note: Found Monuments are not tagged unless otherwise noted.

"No Attempt Was Made to Verify the Monument(s)"

FP=Fence Post
GP=Guy Post
JP=Joint Pole
PP=Power Pole
SP=Service Pole
TP=Telephone Pole
S.F.N=Searched Found Nothing
N.T.S.=Not To Scale
Set=Conc. Nail with Brass Washer Stamped
"S.J. Co.", unless otherwise noted