
CORNER RECORD	Document Number 07-41
City of	County of SAN JOAQUIN , California
Brief Legal Description SouthWEST CORNER OF	INTERSECTION OF TULLY ROAD AND
	TION 30 OF TAN RSE OF MDB 1 M
CORNER TYPE	COORDINATES(Optional)
Government Corner Contr	N
Meander Prope	rty Zone NAD27 NAD83
Rancho Other	NAD83 Epoch
	Elevation
Date of Survey \\\\\\\\\\\\\\\\\\\\\\\\\\\\\\\\\\\\	NAV88 ☐
	Meas. Units: Metric Merial Meas. Units: Metric
Corner - Left as found  Found and tagged	Established Reestablished Rebuilt
Identification and type of corner found: Evidence used to identify of	r procedure used to establish or reestablish the corner:
FOUND A CHISELED "X" IN THE SIDEWA	LK AT THE SOUTHWEST CORNER OF
THE INTERSECTION OF TULLY ROAD	AND STATE ROUTE 88. PER MAP
22/RS/131	
SET REFERENCE POINTS TO RE-ESTAR	SUSH AFTER CONSTRUCTION.
SEE SKETCH.	•
A description of the physical condition of the manument as found	and as set or reset.
A description of the physical condition of the monument as found and as set or reset:	
MOHUMENT WAS FOUND IN GOOD CONDITION.	
SURVEYOR'S STATEMENT	ion in conformance with  2007.
This Corner Record was prepared by me or under my direction in conformance with	
the Land Surveyor's Act on 25 Oct , 2007.	
Signed Signed P.L.S. or R.C.E. For the State of California	Number   No. 6100
Department of Transportation	*\ Exp. \(\frac{3\lambda{3\lambda{1\lambda{1}}\lambda{8}}{\pi}\)
COUNTY SURVEYOR'S STATEME	NT \\ \\ \\ \\ \\ \\ \\ \\ \\ \\ \\ \\ \\
This Corner Record was received NOVEMBER 8,	2007 and examined
and filed NOVEMBER 13 Zoo7	
Signed Signed P.L.S. or R.C.	Number 4440
Title Assistant County Serveyor	LES LEF D. LUZ PZ
County Surveyor's Comment This CORNER TO	. NO AAAO 1011
COMPLIANCE WITH BOARD RULE 41	54(C) REGATADING Expires
Submittal WITHIN 90 DAYS FIZOM 1	HE DATE OF \$ 9-30-09
SURVEY.	ONE ONE
	OF CALIFORN

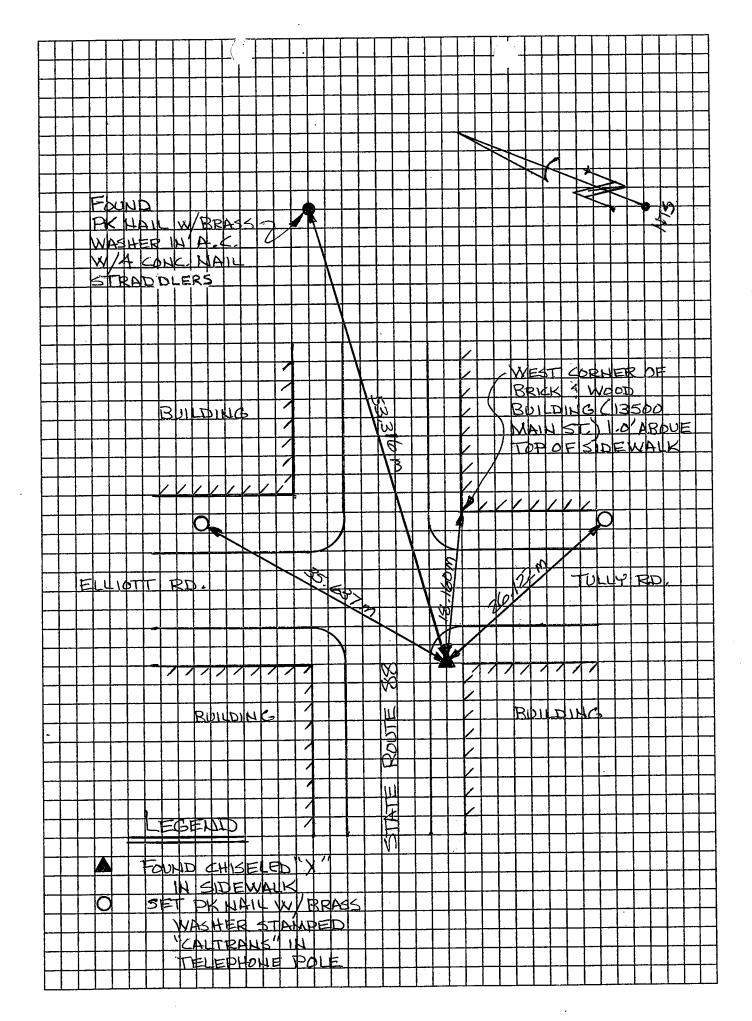

PAGE 2 OF 2