


CORNER RECORD

Document Number 07-42

City of _____

County of SAN JOAQUIN, California

Brief Legal Description SOUTHWEST CORNER OF INTERSECTION OF TULLY ROAD AND STATE ROUTE 88 IN SECTION 30 OF T4N, R8E OF MDB 'M

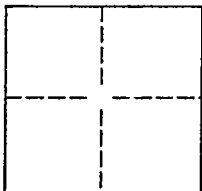

CORNER TYPE

COORDINATES(Optional)

Government Corner ☐ Control ☐
Meander ☐ Property ☒
Rancho ☐ Other ☐

N. _____
E. _____
Zone _____ NAD27 ☐ NAD83 ☐
NAD83 Epoch _____
Elevation _____
Vert. Datum: NGVD29 ☐ NAV88 ☐
Meas. Units: Metric ☒ Imperial ☐

Date of Survey 4/26/04

Corner - Left as found ☐ Found and tagged ☐ Established ☐ Reestablished ☒ Rebuilt ☐

Identification and type of corner found: Evidence used to identify or procedure used to establish or reestablish the corner:

SET PK NAIL W/BRASS WASHER STAMPED "CALTRANS" IN CONCRETE
USING FOUND REFERENCE POINTS FROM PREVIOUS CORNER RECORD.
(CR-07-41)

A description of the physical condition of the monument as found and as set or reset: _____

MONUMENT WAS SET IN GOOD CONDITION.

SURVEYOR'S STATEMENT

This Corner Record was prepared by me or under my direction in conformance with

the Land Surveyor's Act on 25 Oct, 2007.

Signed Gregory A. Hartman P.L.S. or R.C.E. Number LS 6166
For the State of California
Department of Transportation

COUNTY SURVEYOR'S STATEMENT


This Corner Record was received NOVEMBER 8, 2007 and examined

and filed NOVEMBER 13, 2007.

Signed Jeff D. Lund P.L.S. or R.C.E. Number 4440

Title Assistant County Surveyor

County Surveyor's Comment THIS CORNER RECORD IS NOT IN
COMPLIANCE WITH BOARD RULE 464(C) REGARDING
SUBMITTAL WITHIN 90 DAYS FROM THE DATE OF
SURVEY.

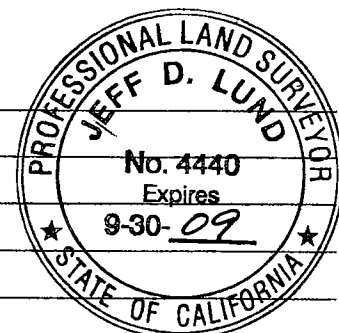

D.D. SHEET Nos. 9 & 10

FOUND
PK NAIL W/ BRASS
WASHER IN A.C.
W/ 4 CONC. NAIL
STRADDLERS

FOUND
PK NAIL W/ BRASS
WASHER STAMPED
"CALTRANS" IN TELE.
POLE 2.0' ABOVE
GROUND

ELLIOTT RD.

BUILDING

BUILDING

STATE ROUTE 88

WEST CORNER OF
BRICK & WOOD
BUILDING (13500
MAIN ST.) 1.0' ABOVE
TOP OF SIDEWALK

TULLY RD.

BUILDING

SET PK NAIL W/ BRASS
WASHER STAMPED
"CALTRANS" IN
CONCRETE