


# CORNER RECORD

Document Number 07-45

City of \_\_\_\_\_

County of San Joaquin, California

Brief Legal Description SJ County Bench Mark SR 21.5

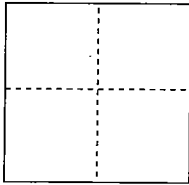

## CORNER TYPE

Government Corner ☐ Control ☐  
Meander ☐ Property ☐  
Rancho ☐ Other ☒

## COORDINATES(Optional)

N. \_\_\_\_\_  
E. \_\_\_\_\_

Zone \_\_\_\_\_ NAD27 ☐ NAD83 ☐

NAD83 Epoch \_\_\_\_\_

Elevation Assumed 100.000 meters

Vert. Datum: Assumed ☒ NADV88 ☐

Meas. Units: Metric ☒ Imperial ☐

Date of Survey February 21, 2006

Corner- Left as found ☒ Found and tagged ☐ Established ☐ Reestablished ☐ Rebuilt ☐

## Identification and type of corner found: Evidence used to identify or procedure used to establish or reestablish the corner:

Found County Bench mark, will probably be destroyed during construction of Hwy 99 widening.

Referenced to two vertical and three horizontal ties.

Assumed BM elevation of 100.000 meters

Reference point 2 elevation is 99.629 meters as determined by digital level run from assumed BM elevation

Reference point 3 elevation is 99.721 meters as determined by digital level run from assumed BM elevation.

Please see sketch on back.

## A description of the physical condition of the monument as found and as set or reset:

Found 2" Brass Disc Stamped "SJ Co. SR 21.5 BM" near the easterly end of pork-chop island between north line of Cherokee and on-ramp to Northbound Hwy 99 on east side of Hwy 99.

Found in good condition and referenced to three ties as shown in sketch on back

## SURVEYOR'S STATEMENT

This Corner Record was prepared by me or under my direction in conformance with

the Land Surveyor's Act on 11/14/07

Signed Matthew J. Stringer P.L.S. or R.C.E. No.: 8151




## COUNTY SURVEYOR'S STATEMENT

This Corner Record was received NOVEMBER 16, 2007, and examined

and filed NOVEMBER 20, 2007.

Signed Jeff D. Lund P.L.S. or R.C.E. No.: 4440

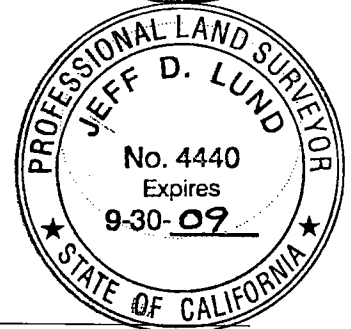

Title Assistant County Surveyor

## County Surveyor's Comment

This Corner Record is not in compliance with Board Rule 464(c) regarding submittal within 90 days from date of survey.

# HIGHWAY 99



NOT TO SCALE

REFERENCE POINT 2  
SET MAG NAIL  
IN PARKING LOT

91.094 METERS

CHEROKEE LANE

ON RAMP HWY 99

103°33'29"

FOUND 2" BRASS DISC  
STAMPED SJ CO. SR 21.5 BM

53.136 METERS

76°26'31"

CALLOWAY  
COURT

125.270 METERS

REFERENCE POINT 3  
SET MAG NAIL  
IN PARKING LOT

REFERENCE POINT 1  
SET MAG NAIL

## CORNER RECORD

for SJ Co. 6M SR 21.5



**MARK THOMAS & COMPANY, INC.**  
Providing Engineering, Surveying, and Planning Services  
7300 Folsom Boulevard, Suite 203  
Sacramento, CA 95826  
(916) 381-9100

DRAWN. BY Matt  
CKD. BY DE LEON  
DATE 10/26/07  
SCALE No Scale

APPROVED ON 11/14/2007  
BY Matt Stringer  
I.S. NO. 8:51 12/31/2008

JOB NO.  
71-98125

FILE NO.

Page  
2 /  
OF  
2