


CORNER RECORD

Document Number 07-48

City of Lodi

County of San Joaquin, California

Brief Legal Description Center 1/4 and South 1/4 Section 15 T.3 N. R.6 E. M.D.M.

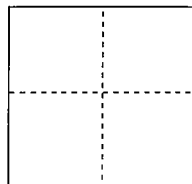

CORNER TYPE

Government Corner ☒ Control ☐
Meander ☐ Property ☐
Rancho ☐ Other ☐

COORDINATES(Optional)

N. _____
E. _____
Zone _____ NAD27 ☐ NAD83 ☐
NAD83 Epoch _____
Elevation _____
Vert. Datum: NGVD29 ☐ NADV88 ☐
Meas. Units: Metric ☐ Imperial ☒

Date of Survey October 11, 2007

Corner- Left as found ☐ Found and tagged ☐ Established ☐ Reestablished ☒ Rebuilt ☐

Identification and type of corner found: Evidence used to identify or procedure used to establish or reestablish the corner:

Two corners on 1/4 Section line of Section 15 destroyed during construction of Lower Sacramento Road.

This is to reference monuments shown on Corner Record: 07-47

A description of the physical condition of the monument as found and as set or reset:

1/2" pin in monument well and intersection of Lower Sacramento Road and Harney Lane – will not be reset due to traffic lanes.

3/4" bolt in monument well at intersection of Lower Sacramento Road and Century Boulevard – reset with well monument as shown.

Please see Sketch on Back

SURVEYOR'S STATEMENT


This Corner Record was prepared by me or under my direction in conformance with

the Land Surveyor's Act on 11/26/07

Signed

Matthew J. Stringer

P.L.S. or R.C.E. No.: 8151

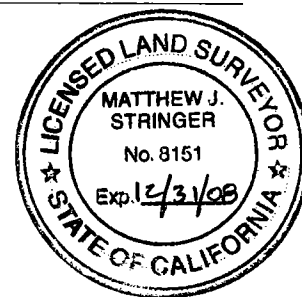

COUNTY SURVEYOR'S STATEMENT

This Corner Record was received NOVEMBER 29, 2007, and examined

and filed DECEMBER 4, 2007

Signed

Jeff D. Lund

P.L.S. or R.C.E. No.: 4440

Title

Assistant County Surveyor

County Surveyor's Comment



