


CORNER RECORD

Document Number 07-49

City of Lodi

County of San Joaquin, California

Brief Legal Description On CL of Kristen Court shown on 17 M&P 128 and 3 PM 11

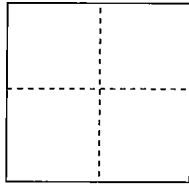

CORNER TYPE

Government Corner ☐ Control ☐
Meander ☐ Property ☒
Rancho ☐ Other ☐

COORDINATES(Optional)

N. _____
E. _____
Zone _____ NAD27 ☐ NAD83 ☐
NAD83 Epoch _____
Elevation _____
Vert. Datum: NGVD29 ☐ NADV88 ☐
Meas. Units: Metric ☐ Imperial ☒

Date of Survey April 11, 2001

Corner- Left as found ☒ Found and tagged ☐ Established ☐ Reestablished ☐ Rebuilt ☐

Identification and type of corner found: Evidence used to identify or procedure used to establish or reestablish the corner:

Found 3/4" rebar in monument well on CL of Kristen Court shown on 17 M&P 128 and 3 PM 11

Monument may be destroyed by widening of Lower Sacramento Road

Please see Sketch on Back

A description of the physical condition of the monument as found and as set or reset:

Found 3/4" rebar in monument well

Monument will not be reset due to location in traffic lanes


Please see Sketch on Back

SURVEYOR'S STATEMENT

This Corner Record was prepared by me or under my direction in conformance with

the Land Surveyor's Act on 11/26/07

Signed Matthew J. Stringer P.L.S. or R.C.E. No.: 8151

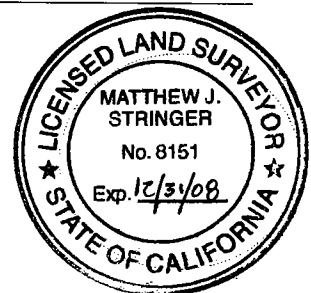


COUNTY SURVEYOR'S STATEMENT

This Corner Record was received NOVEMBER 29, 2007, and examined

and filed DECEMBER 4, 2007

Signed Jeff D. Lund P.L.S. or R.C.E. No.: 4440

Title Assistant County Surveyor

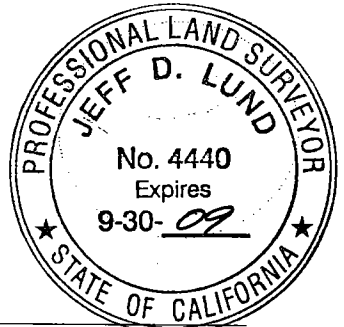

County Surveyor's Comment

This Corner Record is not in compliance with Board Rule 464 (c) regarding submittal within 90 days from date of survey.

DD Sheet No. 15-15A

LOWER SACRAMENTO ROAD

HARTLEY LANE

TEHAMA DRIVE

KRISTEN COURT

N00°08'55"W (NORTH)(A)
329.68' (329.70')(A)

135.00'(A)

S89°10'15"E (A)
505.30'

370.30' (370.32')(A)



(A) per 17 M&P 128

- FOUND 3/4" REBAR
IN MONUMENT WELL (A)
TAG ILLEGIBLE

CORNER RECORD

3/4" PIN ON 17 M&P 128



MARK THOMAS & COMPANY, INC.
Providing Engineering, Surveying, and Planning Services
7300 Folsom Boulevard, Suite 203
Sacramento, CA 95826
(916) 381-9100

DRAWN. BY Matt
CKD. BY DeLeon
DATE 10/22/07
SCALE 1"=40'

APPROVED ON 11/26/07
BY Matt Stringer
LS NO.8151 12/31/2008

JOB NO.
71-51004
FILE NO.

PAGE
2 /
OF
2